


T. 6S., R. 8W., W. M.

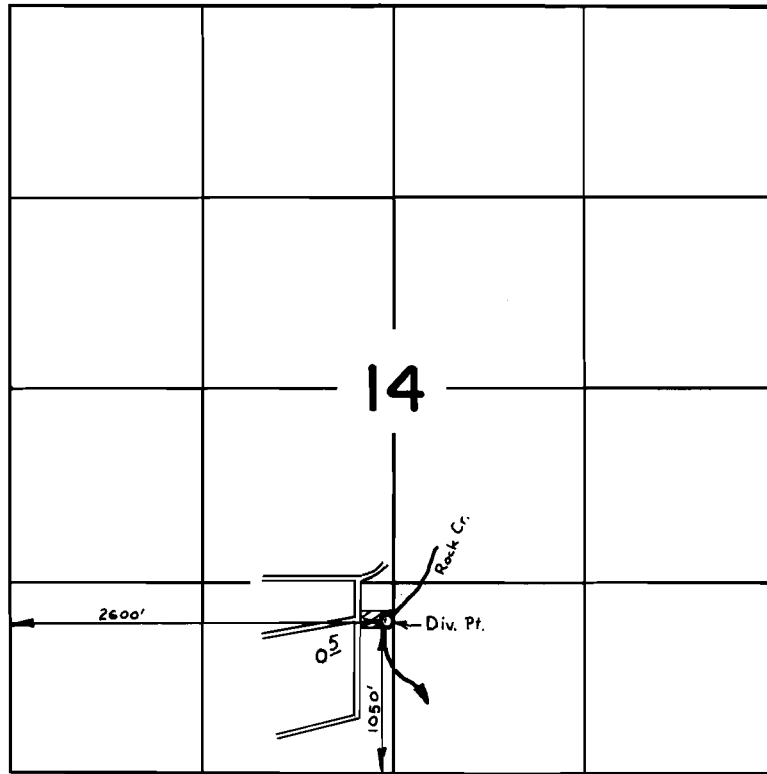

SCALE: 1" = 1320'

**FINAL PROOF SURVEY**  
UNDER

Application No. 62249 Permit No. 45995  
IN NAME OF

RAYMOND L. RICKERD

Surveyed AUG. 2 1983, by L. TOLL