RECEIVED
AUG 21 1981
WATER RESOURCES DEPT
SALEM, OREGON

Application No. 57164

46116

RECORD OF SURVEY
FOR RALPH C. GALES
IN WEST 1/2, SECTION 8, T. 1 N., R.4W., W.M.
Washington County, Oregon.

Scale: 1" = 50' 8 December 1971

RECEIVED
MAY 01 1981
WATER RESOURCES DEPT
SALEM, OREGON

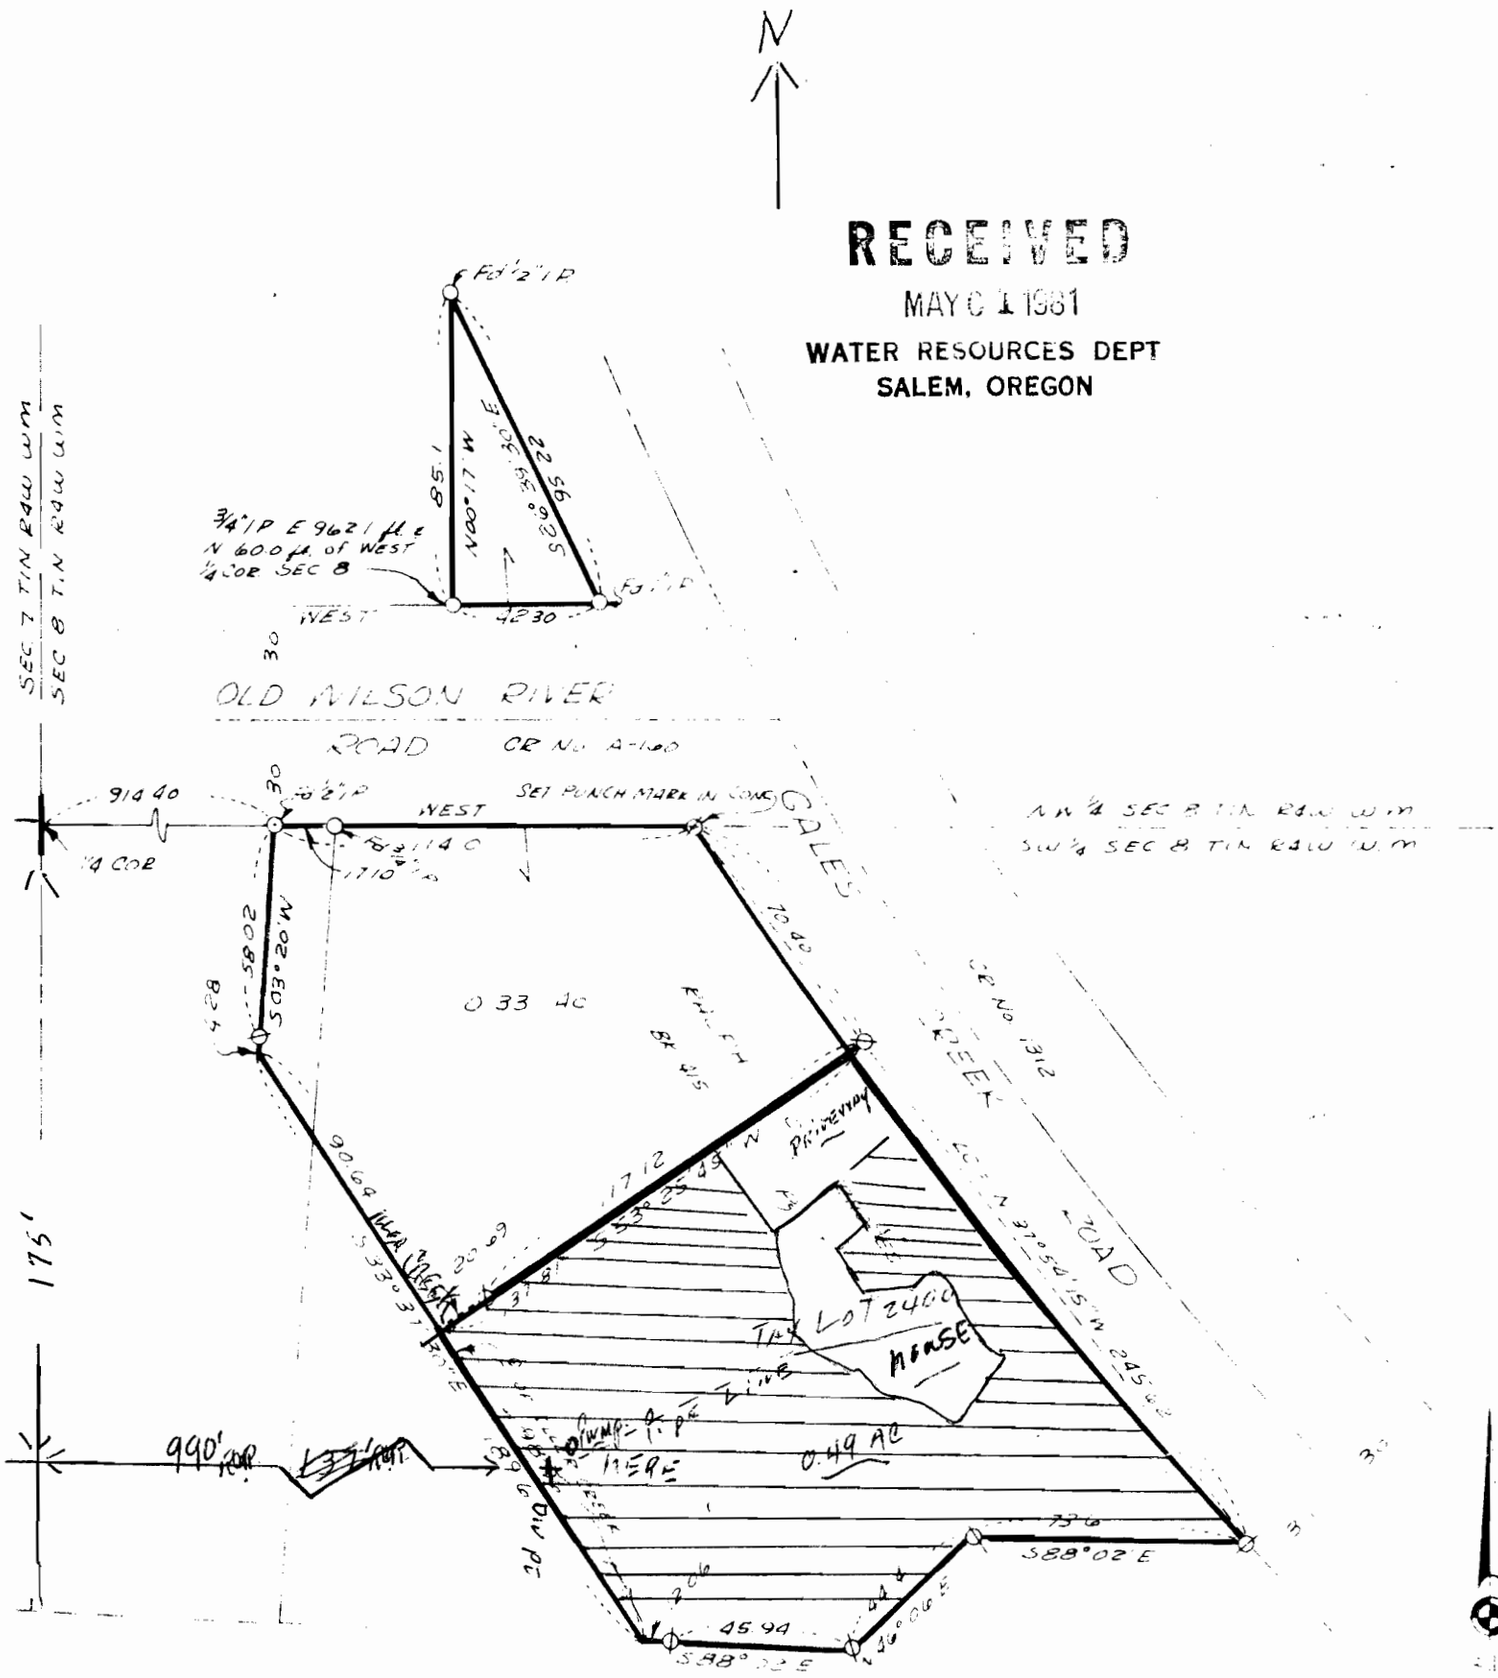

○ FOUND EXISTING MONUMENT AS NOTED

⊗ SET 5/8" x 30" IRON ROD UNLESS OTHERWISE NOTED

BASIS FOR BEARINGS
CS No. 6820 (P)

L. A. mohr & ASSOCIATES
CIVIL ENGINEERS
Job No. 45211