




T.18S.,R.2&3W.,W.M.

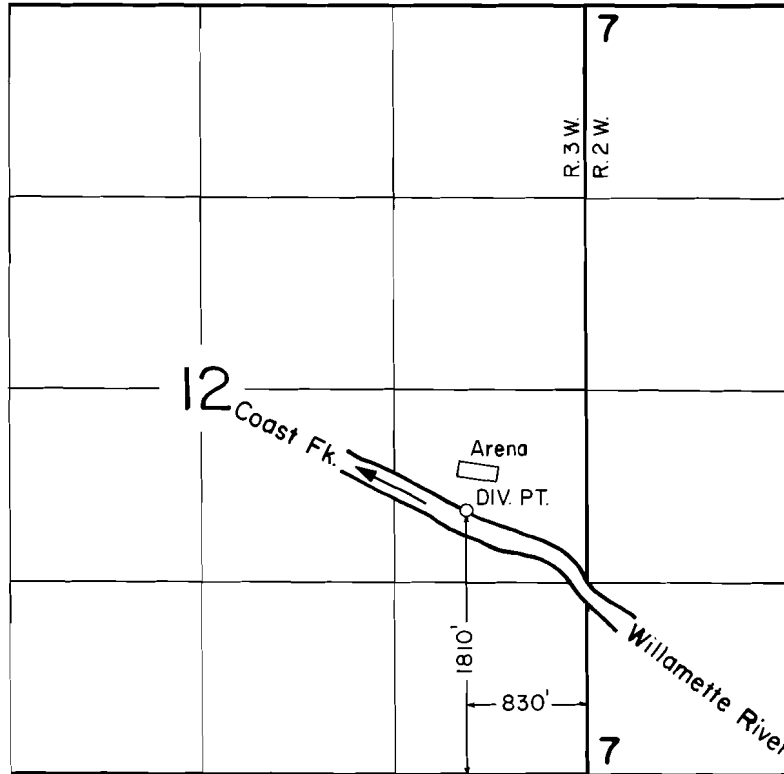

SCALE: 1" = 1320'

FINAL PROOF SURVEY
UNDER

Application No. 60483... Permit No. 46289...
IN NAME OF

PARKS & OPEN SPACE DIVISION, LANE COUNTY

Surveyed OCT. 16... 1986, by T. WARREN.....