



T.5S., R.6W., W.M.

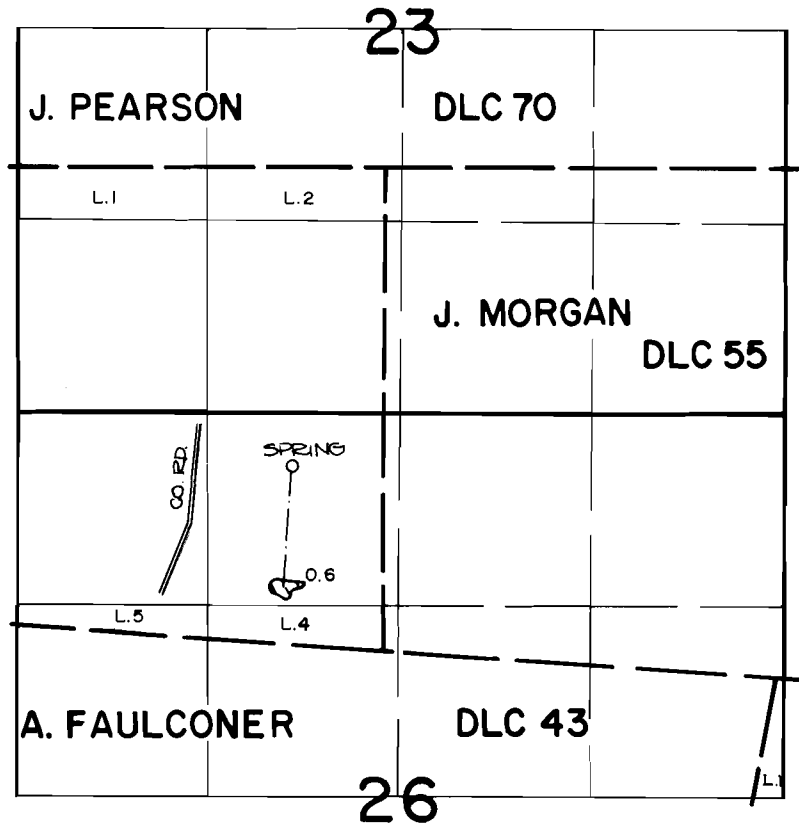

SPRING LOCATION: 360 FT. S. AND 630 FT. W. FROM THE
N. 1/4 CORNER OF SECTION 26.

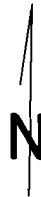

FINAL PROOF SURVEY
UNDER

SCALE: 4" = 1 MILE

Application No. 62063.. Permit No. 46348.....
IN NAME OF

.....**ROBERT M. BOWEN**.....

Surveyed NOV. 7, 1984, by *P. Paster*.....