

RECEIVED

JAN 8 1982

WATER RESOURCES DEPT.

SALEM, OREGON


RECEIVED

AUG 7 1981

WATER RESOURCES DEPT.

SALEM, OREGON

T. 4 N. R. 28 E. W.M.

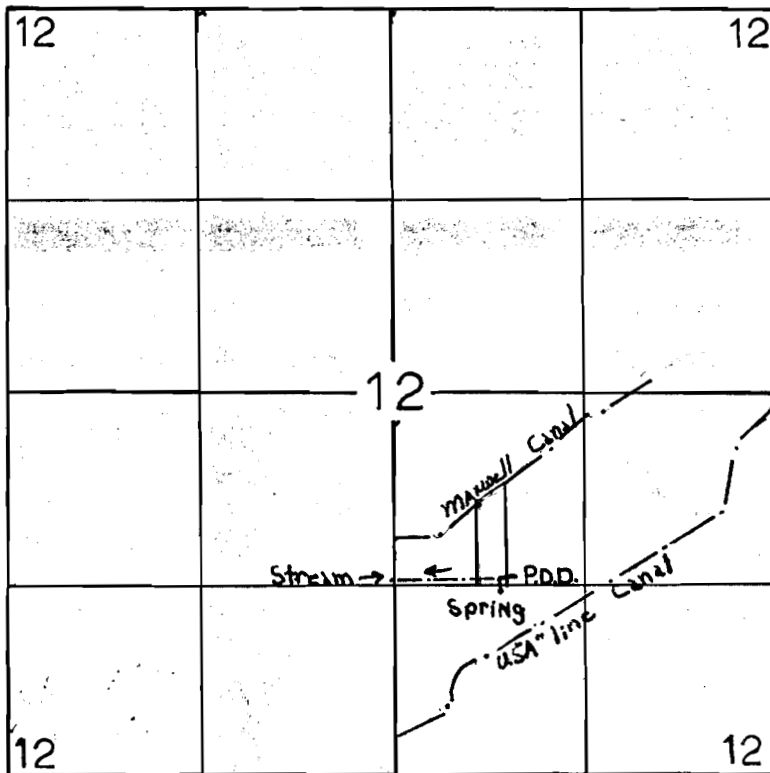

4"=1 Mile

POD

1315' S. 720' E. From The
Center of Section 12

12 OPEN DITCH

Application No. 62149
Permit No. 46378