


T.19S.,R.1W.,W.M.

Section 33

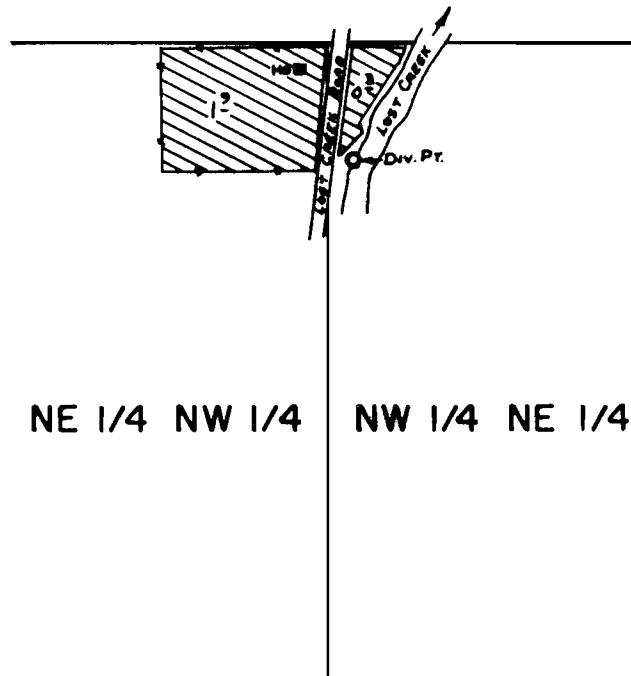

DIV. LOC: 240 FT. S AND 60 FT. E FROM N $\frac{1}{4}$ COR. SEC 33

SCALE: 1" = 400'

FINAL PROOF SURVEY
UNDER

Application No. 62152.. Permit No. 46379..
IN NAME OF

.....LEATHA F. RAY.....

Surveyed Aug...3.... 1982, by L.M. TOLL.....