
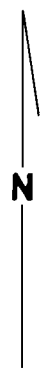


T. 35 S., R. 6 W., W.M.

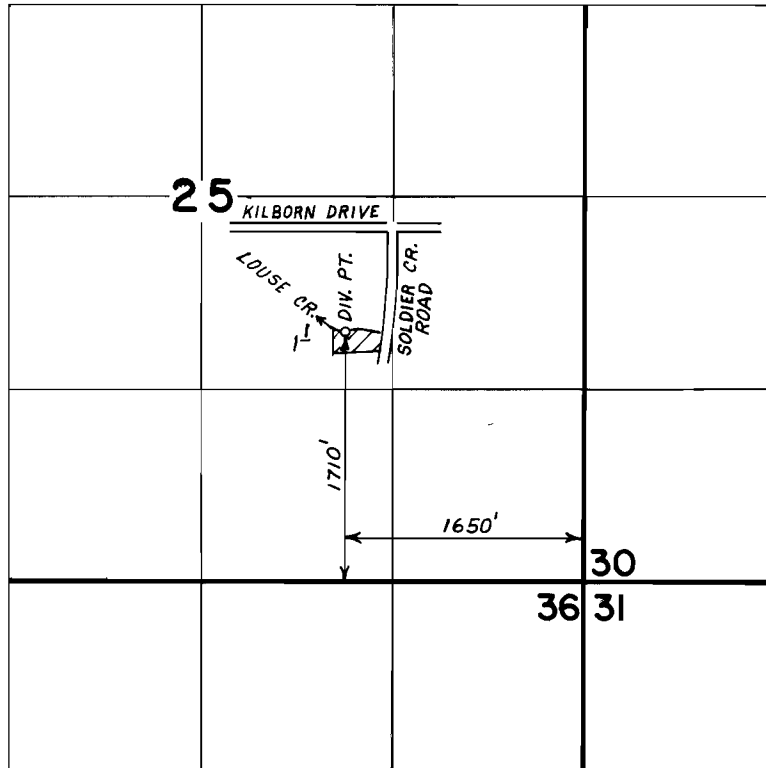

SCALE: 1" = 1320'

FINAL PROOF SURVEY
UNDER

Application No. **62353** Permit No. **46417**.....
IN NAME OF

.....**THOMAS O. ROBERTSON**.....

Surveyed **JULY 10** 19**84**, by **B. S. JAMES**.....