


T.19S., R.1W., W.M.

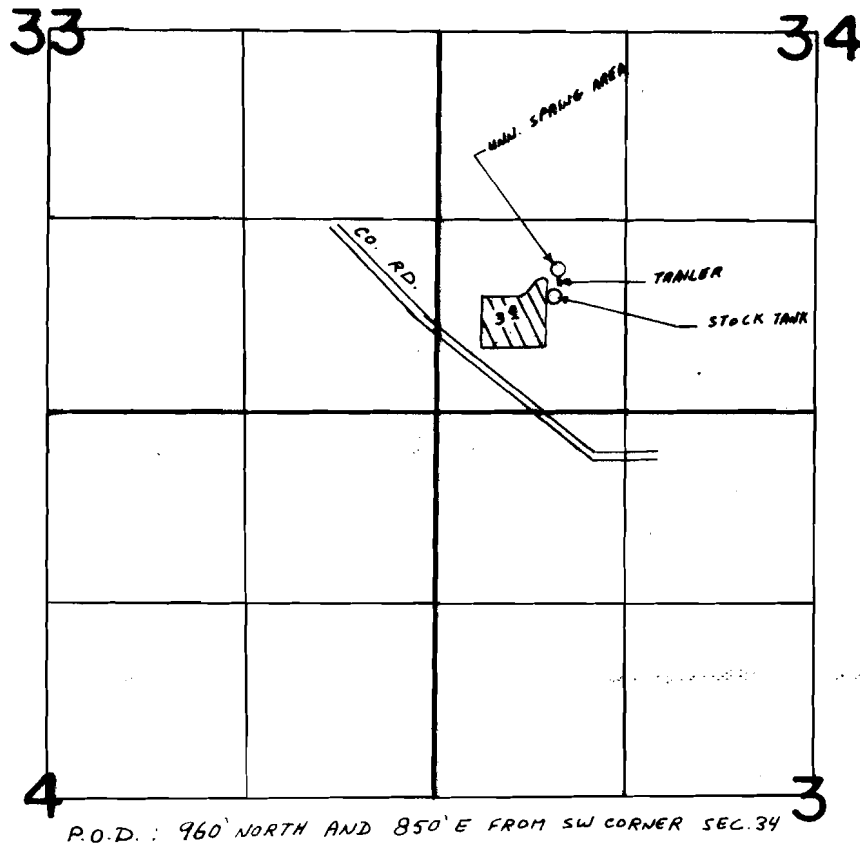

P.O.D. : 960' NORTH AND 850' E FROM SW CORNER SEC. 34

SCALE 1" = 1320'

FINAL PROOF SURVEY
UNDER

Application No. 61196 Permit No. 46505
IN NAME OF

WILLIAM J. BEALS, JR.

Surveyed MAY 25, 1988, by Z. SALEH

DBQ-40J-99
5-11-89 Z.f.S.