


T. 40 S., R. 8 W., W. M.

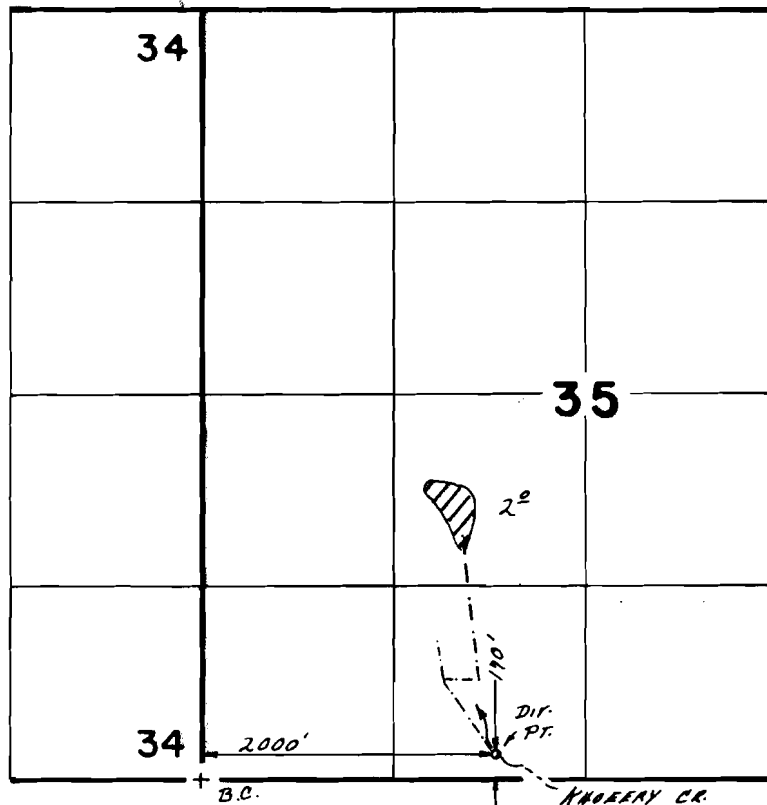

SCALE: 1" = 1320'

FINAL PROOF SURVEY
UNDER

Application No. 62746 Permit No. 46588
IN NAME OF

JOSEPH WILLIAM PATTON

Surveyed A.P.R. 3 1986, by B. S JAMES.