


RECEIVED

MAR 2 1982
WATER RESOURCES DEPT.
SALEM, OREGON

T. 5S. R. 3W. W.M.

**Application No. 63376
Permit No. 46745**

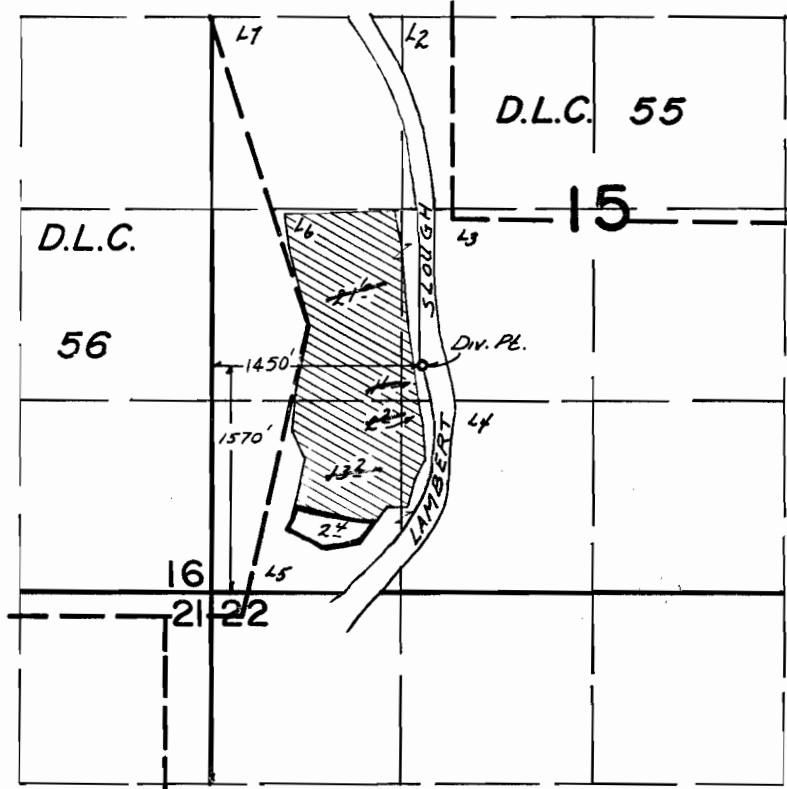

FINAL PROOF SURVEY
UNDER

Application No. ~~55396~~ **63940** Permit No. ~~41806~~ **40241**
IN NAME OF

JAMES C. SHELBURNE

Surveyed **March 6, 1978**, by **L.H. Nunn**