


T. 6S., R. 1W., W.M.

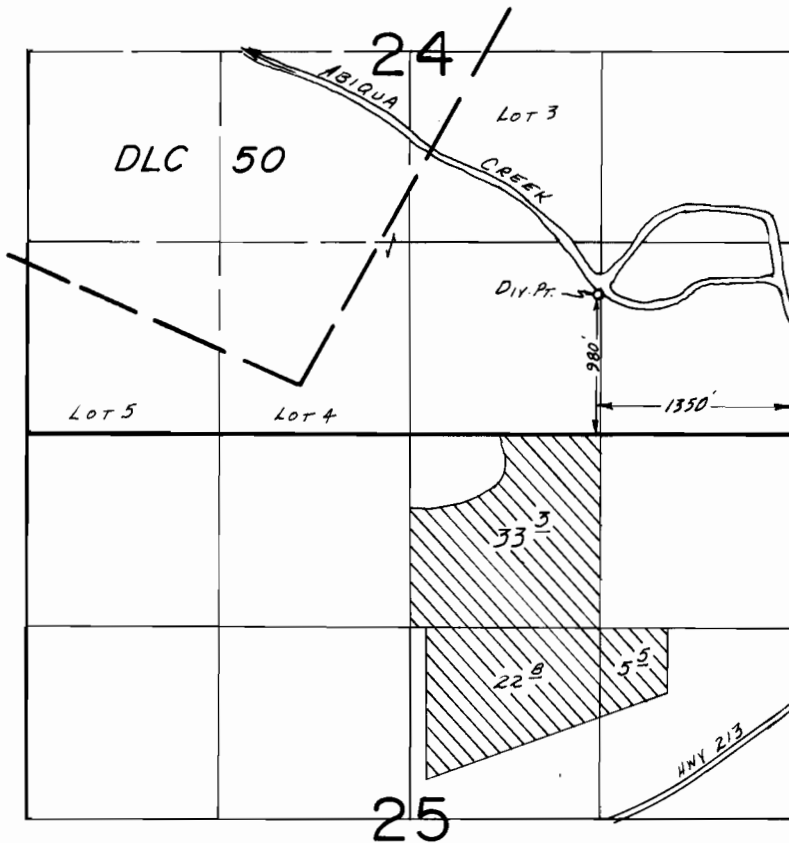

SCALE: 1"=1320'

FINAL PROOF SURVEY UNDER

Application No. 63379... Permit No. 46747.....
IN NAME OF

.....FRANCIS GUBBELS.....

Surveyed May 30... 19.84., by B.W. BISHOP.....