T.27S. R.6W. W.M.

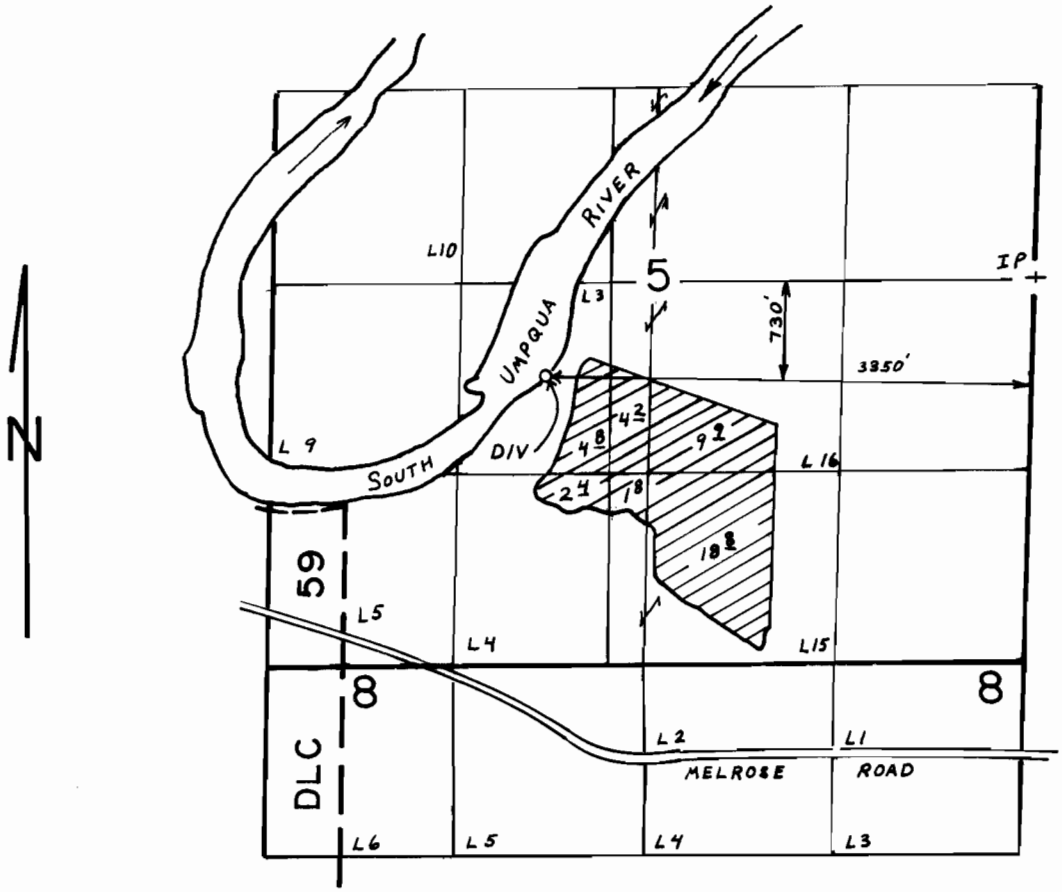

SCALE: 4" = 1 mile

FINAL PROOF SURVEY
UNDER

Application No. 63385 Permit No. 46750
IN NAME OF

ROBERT R. BONEBRAKE

Surveyed DEC. 5. 1983, by L. Cashion

41019-278 10TD LEC