


T. 26 S., R. 6 W., W.M.

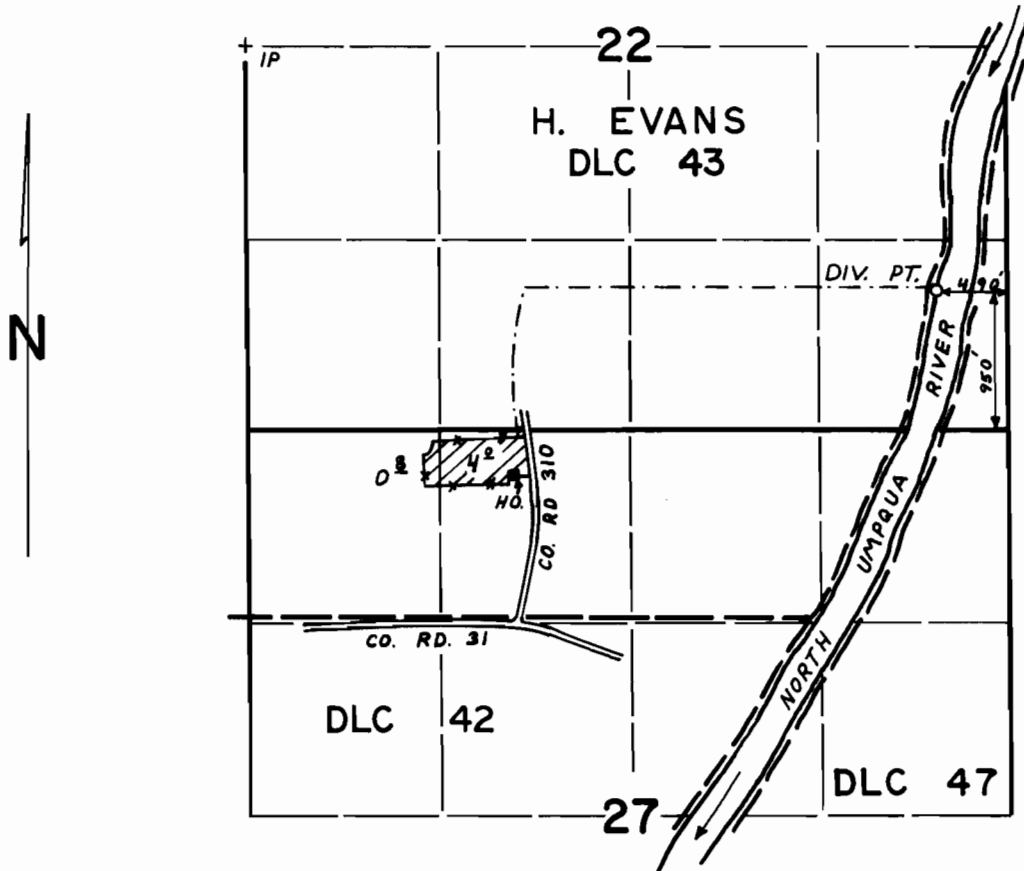

SCALE: 4" = 1 mile

FINAL PROOF SURVEY
UNDER

Application No. .63411.. Permit No. 4.6768....
IN NAME OF

PRESTON & CHARLENE COCKRELL

Surveyed NOV. 8 19.83, by *L. E. Cashion*