


T.27S., R.6W., W.M.
SEC. 16

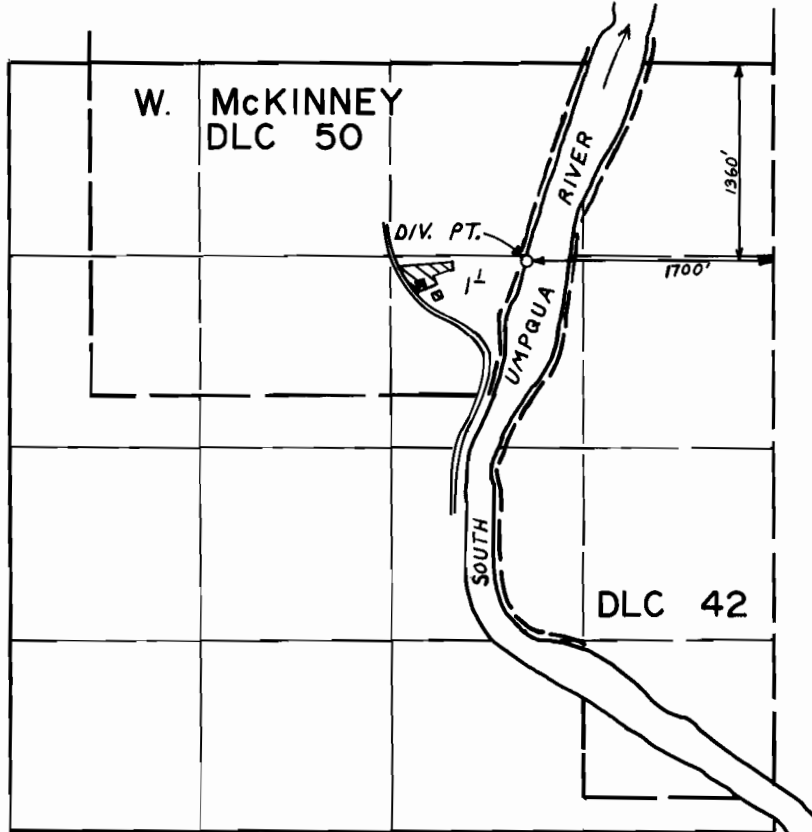

SCALE: 4" = 1 mile

FINAL PROOF SURVEY
UNDER

Application No. 63436 Permit No. 46778.....
IN NAME OF

ARTHUR IRVING and LINDA LEE TAGGART

Surveyed DEC. 5, 1984, by J. E. Cashion