


T.5S., R.3W., W.M.

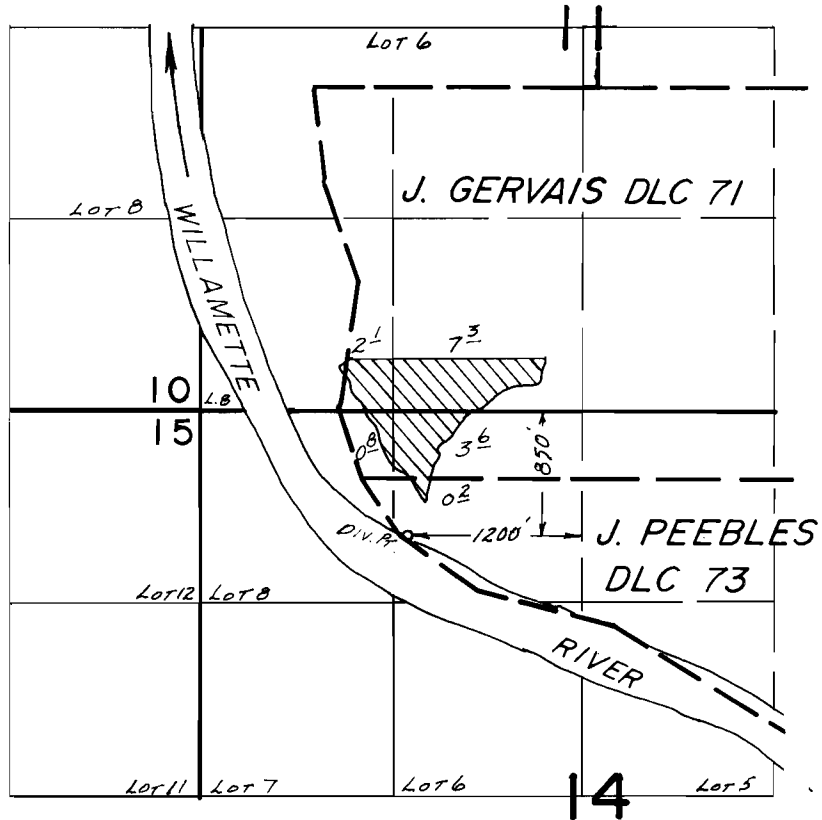

FINAL PROOF SURVEY
UNDER

Application No. 63486.. Permit No. 46820.....
IN NAME OF

.....STEPHEN D. COLEMAN.....

Surveyed Sept. 28. 19.83., by L. M. TOLL.....