


T.26S. R.6W. W.M.

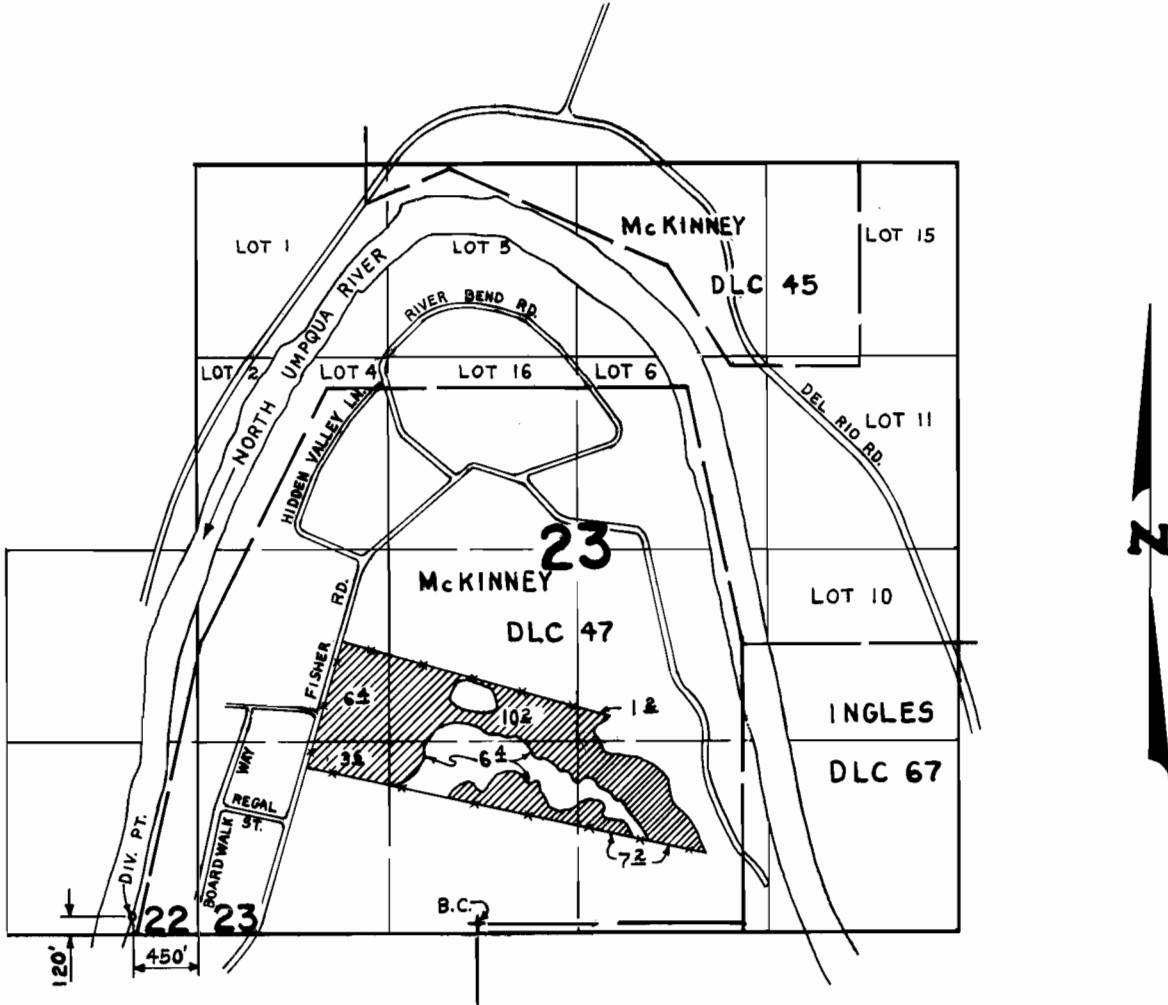

SCALE: 4" = 1 mile

FINAL PROOF SURVEY
UNDER

Application No. ~~63536~~ Permit No. ~~46851~~.....
IN NAME OF

JAMES C. & CAROL KYLE

Surveyed DEC. 9. 19.83, by L. CASHION.