


T. 29 S., R. 6 W., W.M.

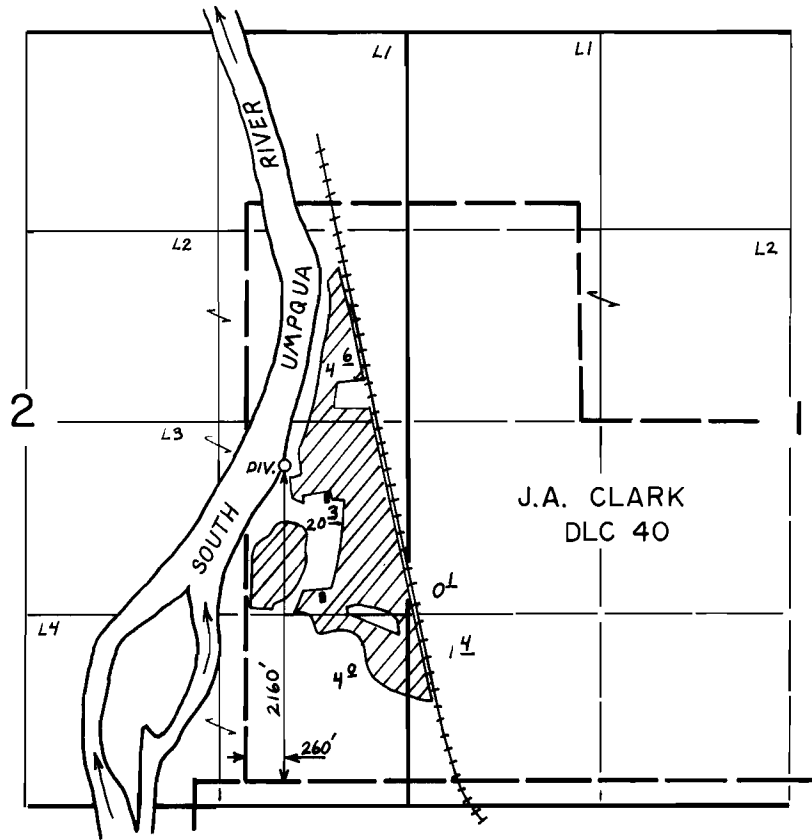

SCALE: 4" = 1 mile

FINAL PROOF SURVEY
UNDER

Application No. 63595 Permit No. 46854.....
IN NAME OF

ROY D. GARREN

Surveyed JULY 3, 1984, by *L.E. Cashion*.....