


# T. 28S., R. 6W., W.M.

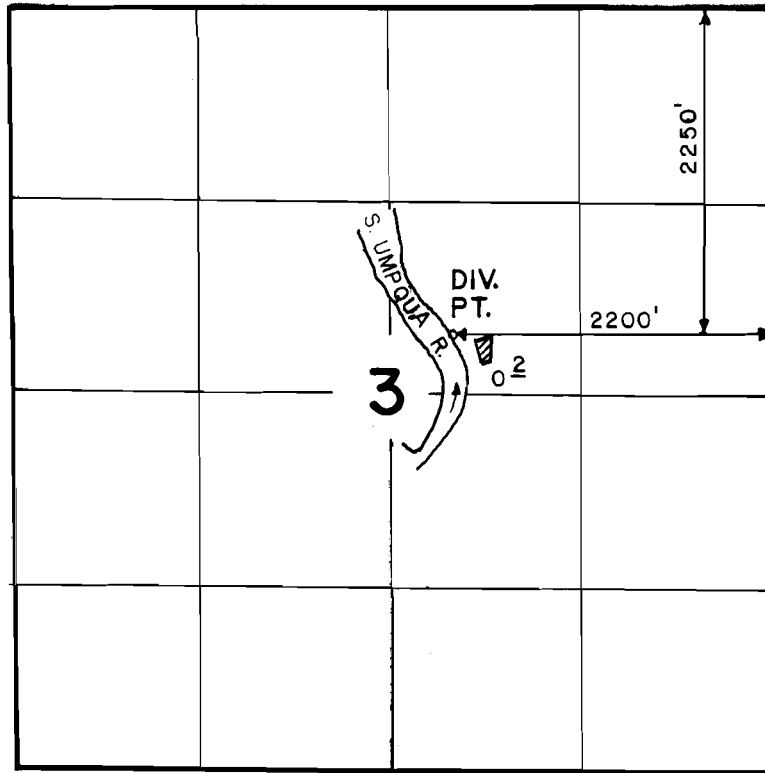

SCALE: 4" = 1 MILE

## FINAL PROOF SURVEY UNDER

Application No. 63740 Permit No. 46902  
IN NAME OF

BEATRICE CORNILSEN

Surveyed DEC. 6, 1983, by L. E. CASHION