


Application No. 63749

Permit No. 46905

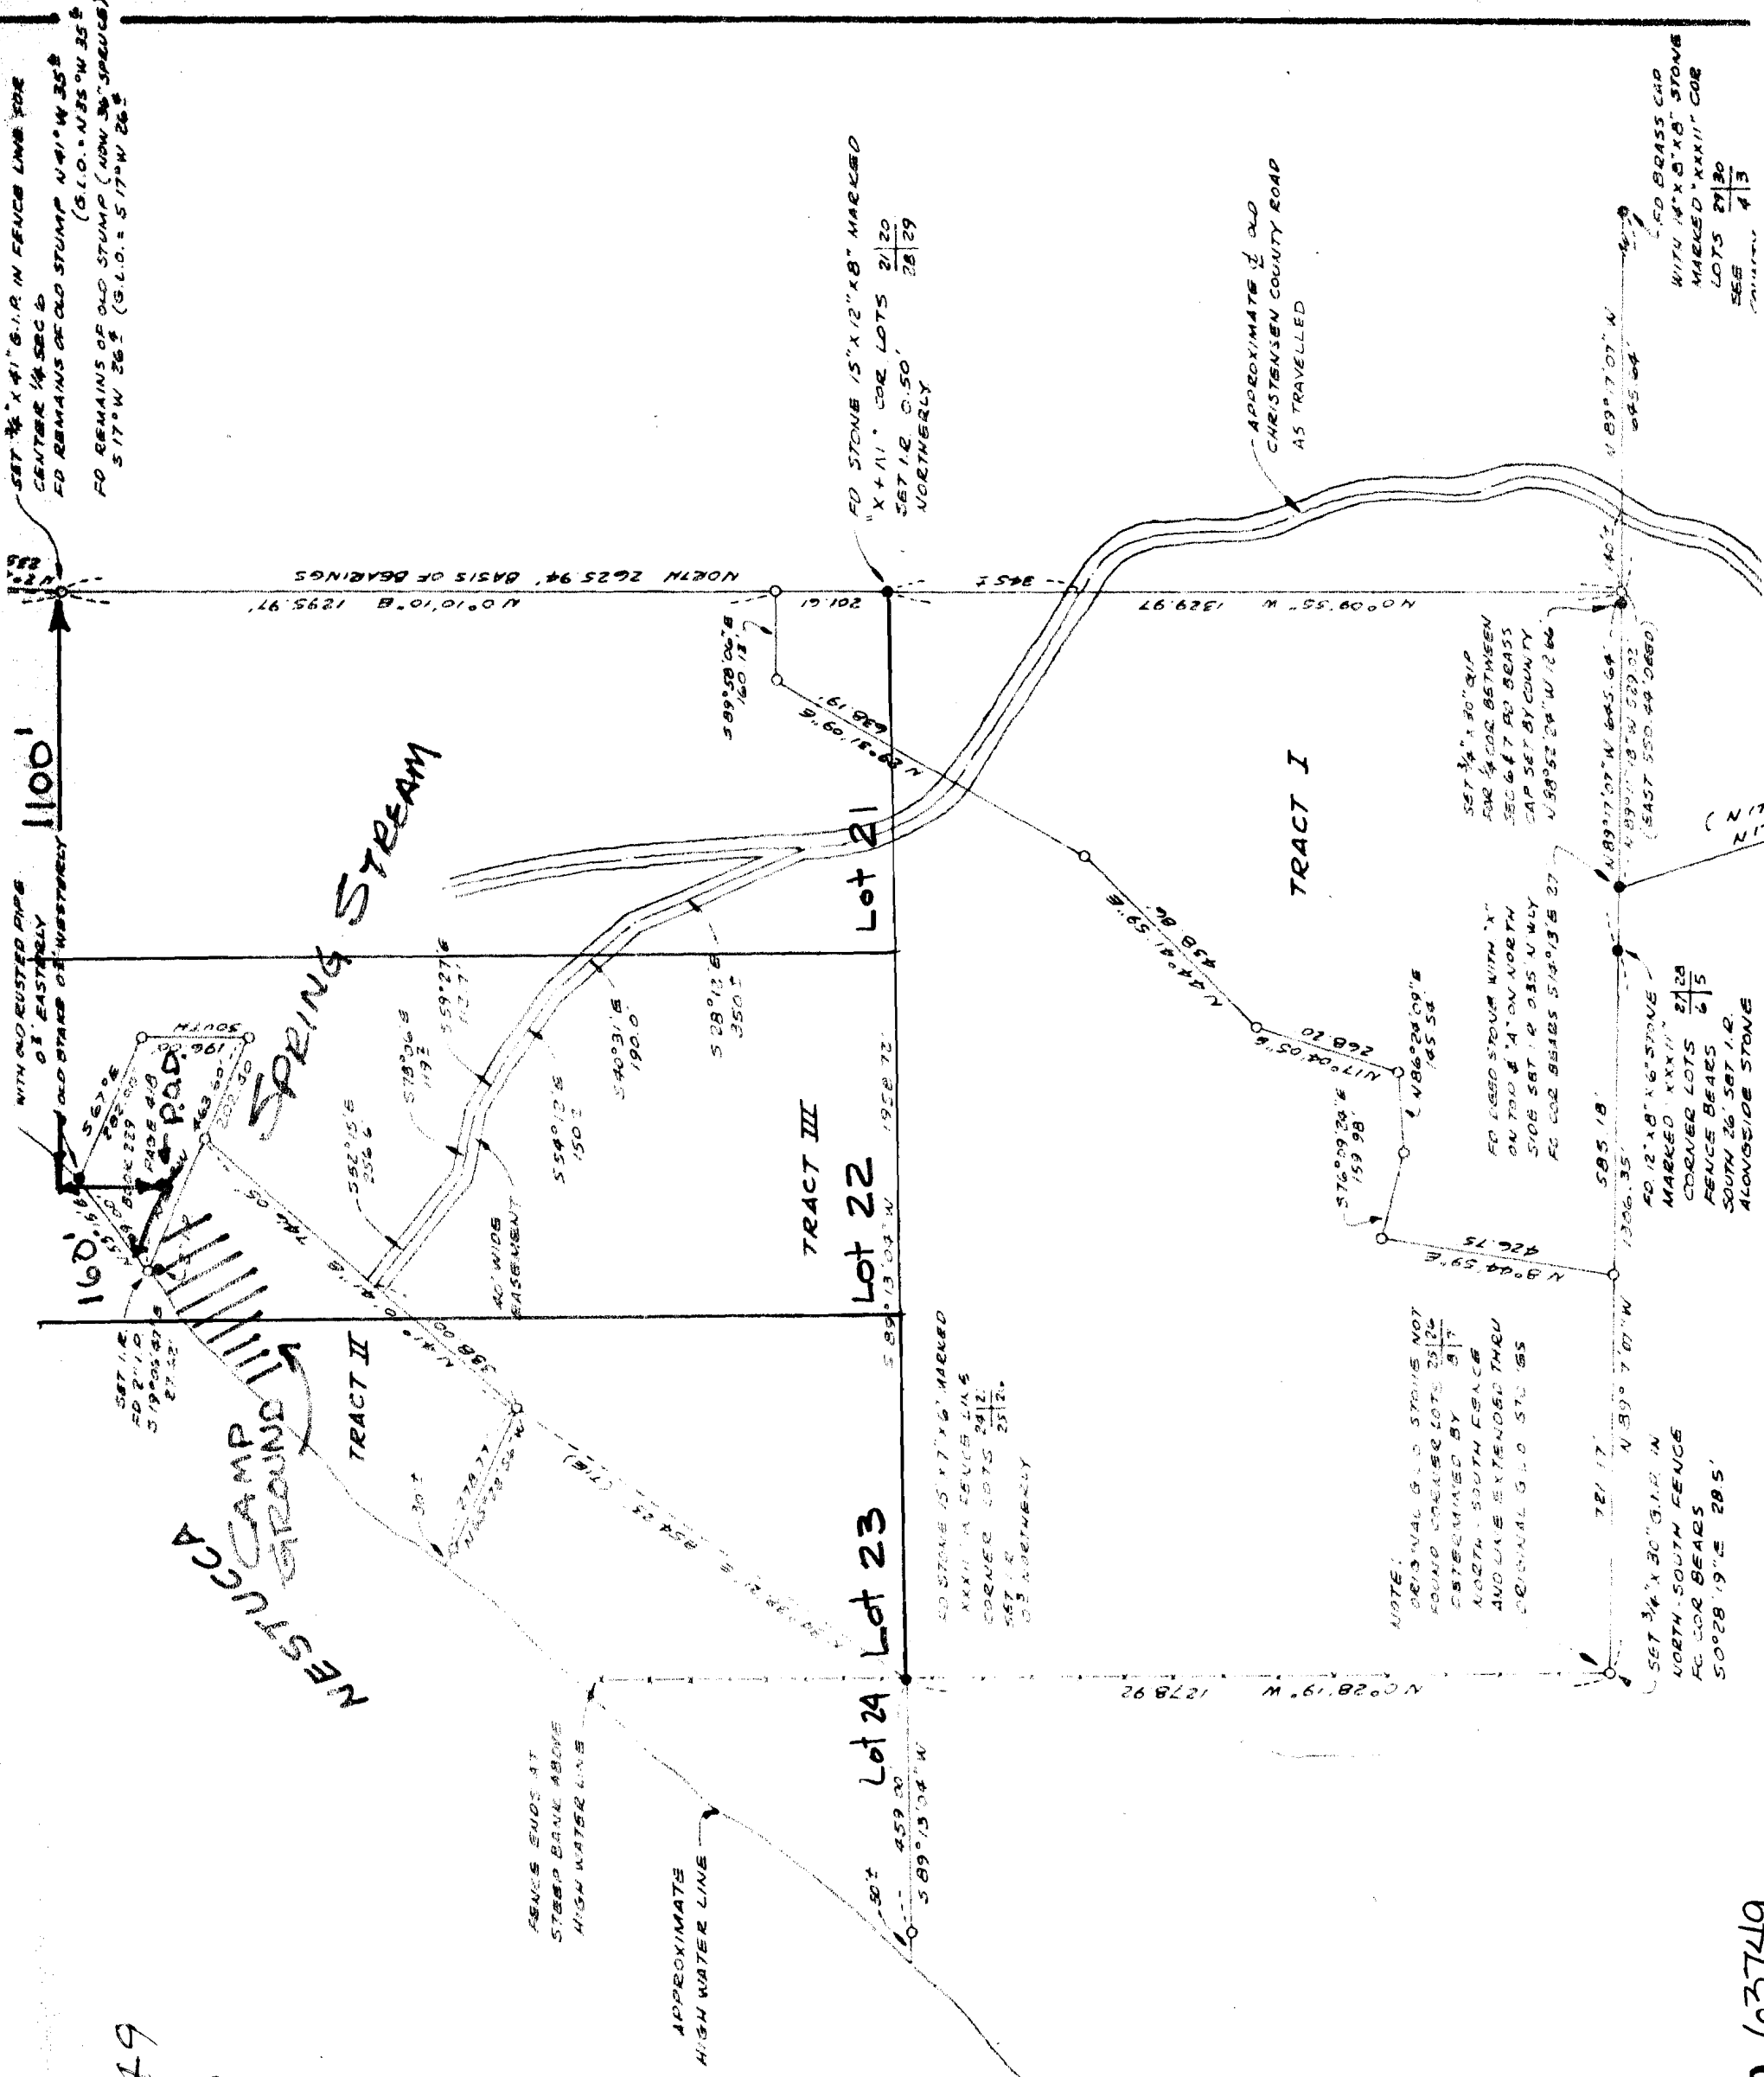

SCALE 1" = 300'

Application No. 63749