


T.29S., R.5W., W.M.

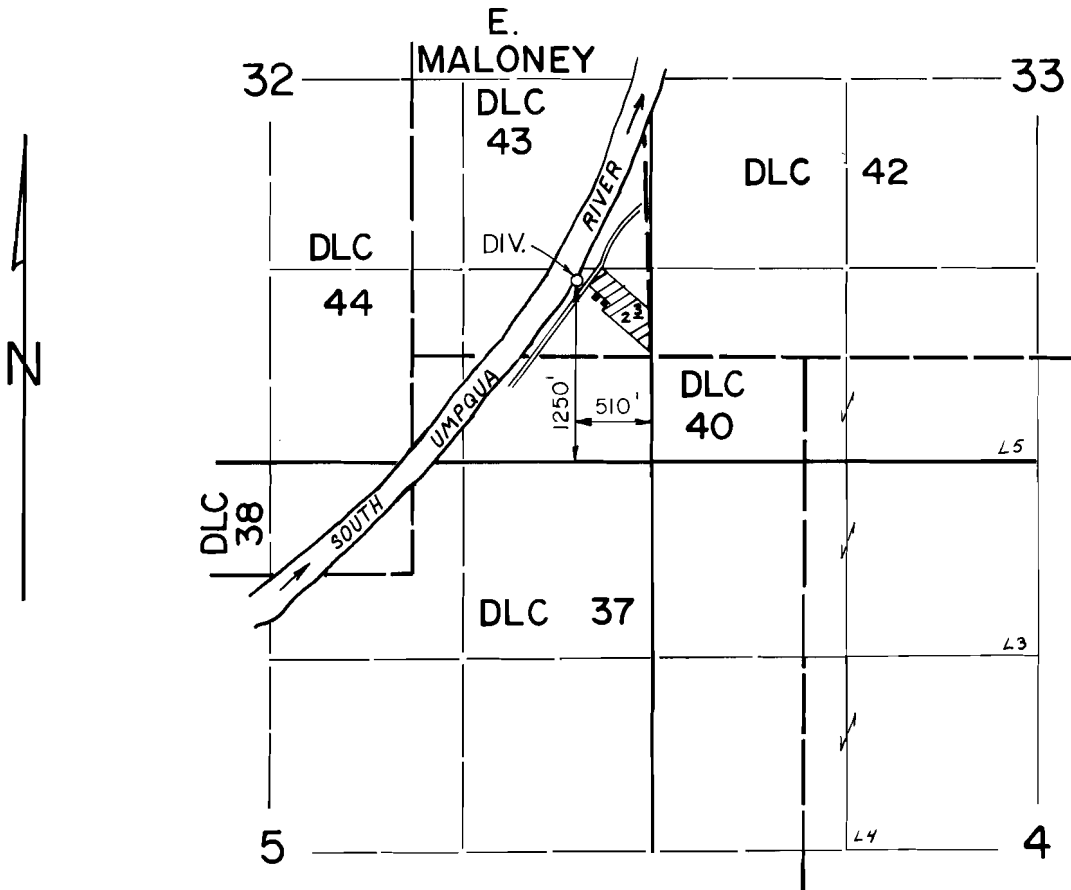

SCALE: 4" = 1 mile

FINAL PROOF SURVEY
UNDER

Application No. ~~63764~~ Permit No. ~~46907~~.....
IN NAME OF

BOBBY J. PFEUFFER.....

Surveyed MAY 24, 1984, by D. CLARK.....