


T.2S., R.2W., W.M.

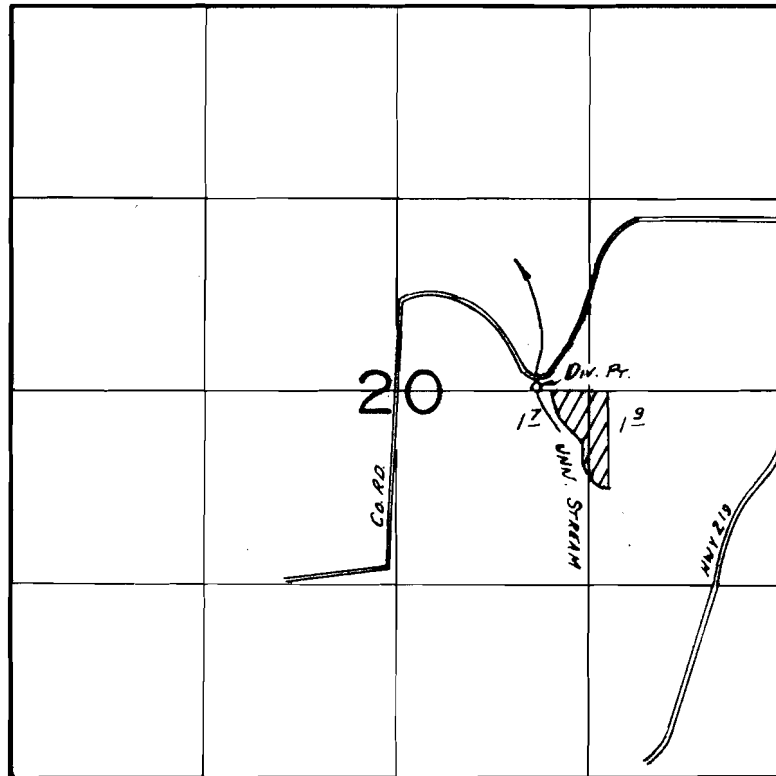

Div. Pt. Loc.: 20' N. & 1690' W. FROM E 1/4 COR. SEC. 20

SCALE: 1"=1320'

FINAL PROOF SURVEY

UNDER

Application No. 63820... Permit No. 47001.....
IN NAME OF

TERRANCE L. & ELIZABETH J. CUDDEFORD

Surveyed July 18... 1984, by B.W. BISHOP.....