


T. 8 S., R. 10 W., W. M.

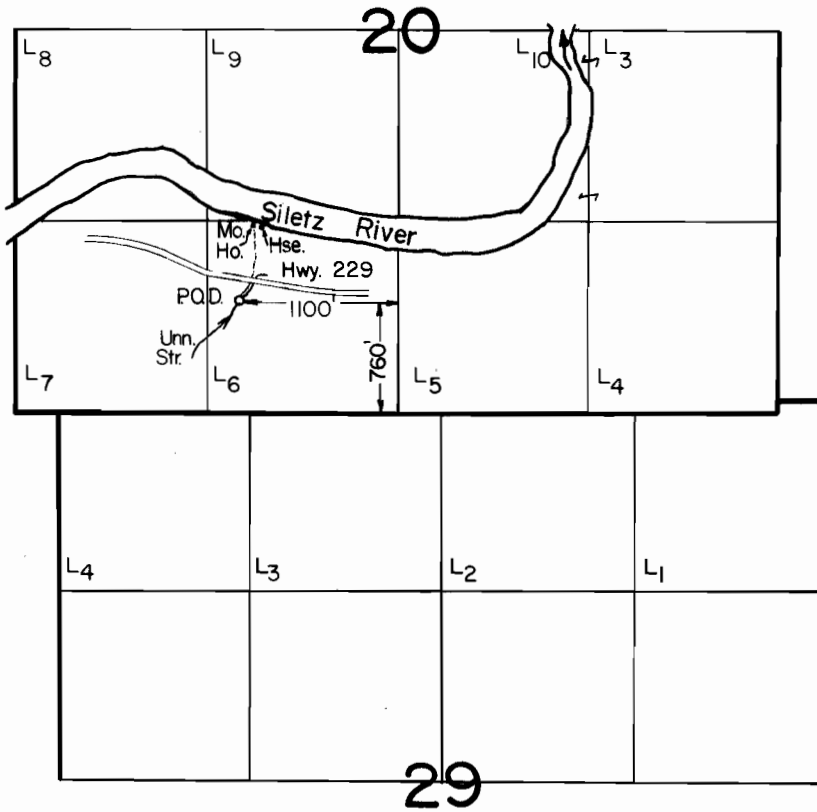

Scale: 1" = 1320'

FINAL PROOF SURVEY UNDER

Application No. 63952 Permit No. 47053 (Hse.)
63953 Permit No. 47054 (Mo. Ho.)
 IN NAME OF

KENNETH E. & LOIS E. ROSS

Surveyed JUNE 18, 1986, by T. Warren