


T. 4S., R. 10W., W.M.

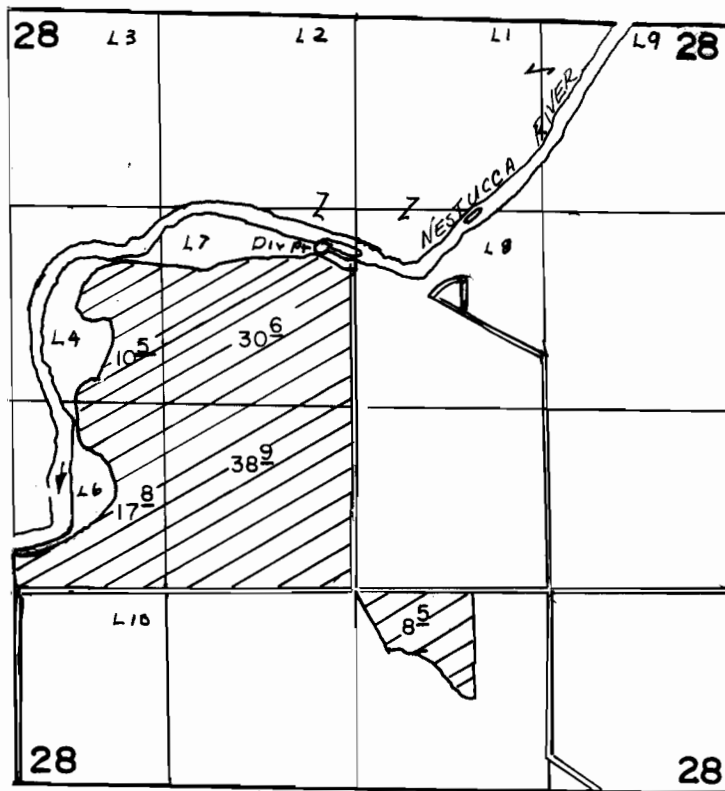

Div Pt Located 1500' S. & 2150' E. From NW Corner Section 20

SCALE: 1"=1320'

FINAL PROOF SURVEY UNDER

Application No. **53522** Permit No. **47204**
IN NAME OF

GENE M. CABRAL

Surveyed **SEPT. 28, 1987**, by **B.W. BISHOP**