


T. 17 S., R. 1 E., WM.

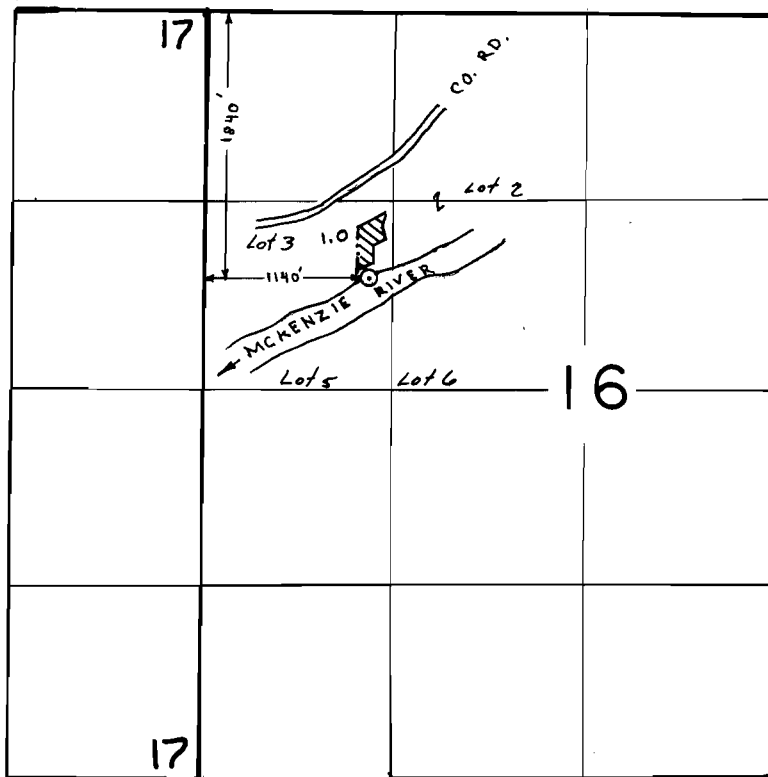

**FINAL PROOF SURVEY**  
UNDER

Application No. 63281, Permit No. 47250  
IN NAME OF

LAURIE HOLSINGER

Surveyed NOV. 16, 1983, by P. PAGTER