


T.1S., R.3W., W.M.

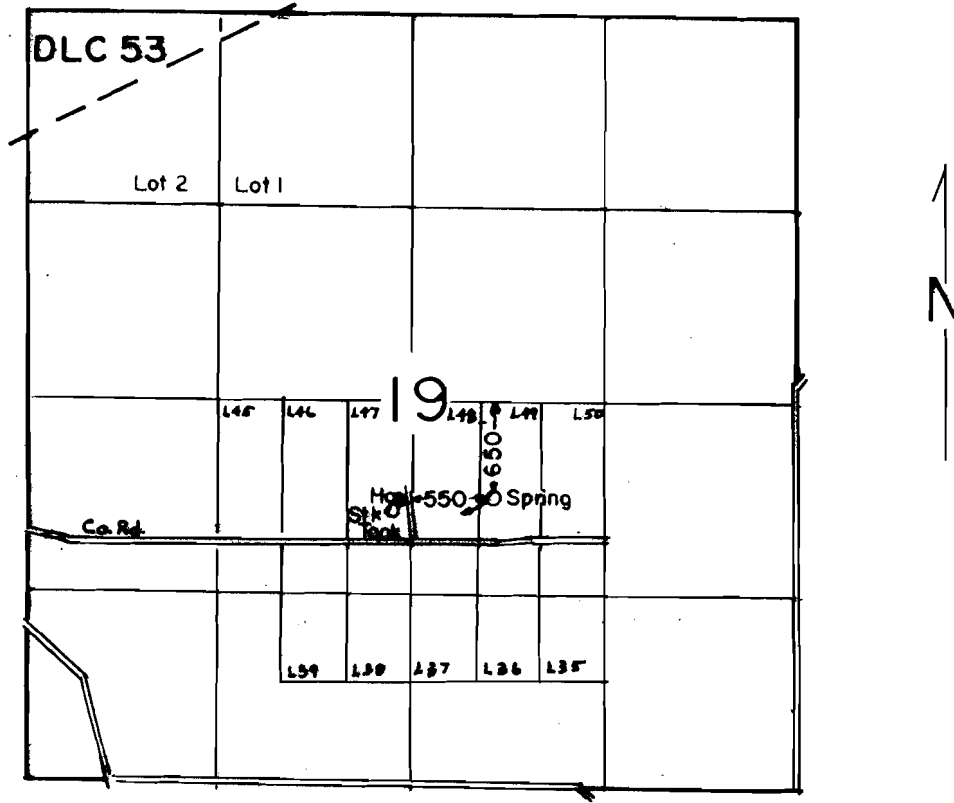

SCALE: 1" = 1320'

FINAL PROOF SURVEY
UNDER

Application No. 63826... Permit No. 47414.....
IN NAME OF

.....GARY DEAN NORDHOLM.....

Surveyed AUG. 22. 1986., by B.W BISHOP.....