


T.1S., R.3W., W.M.

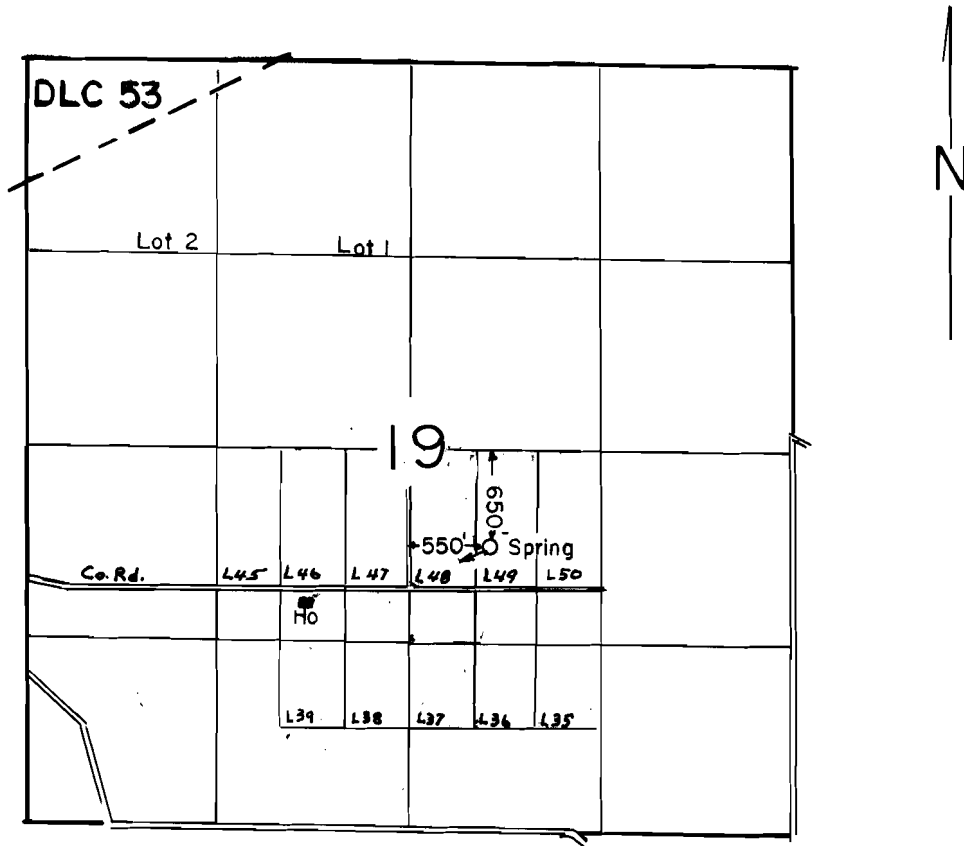

SCALE: 1"=1320'

FINAL PROOF SURVEY
UNDER

Application No. 63807... Permit No. 47450.....
IN NAME OF

JACK A LLOYD

Surveyed AUG..22.. 1986.., by B.W.BISHOP.....