


T. 5S., R. 4W., W.M.

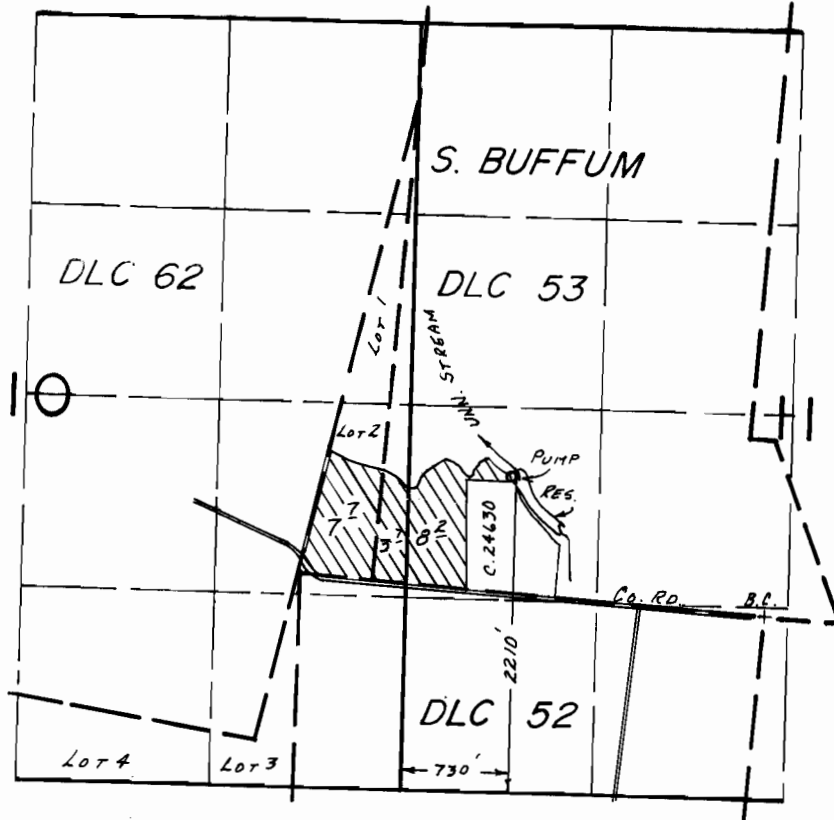

SCALE: 1" = 1320'

**FINAL PROOF SURVEY**  
UNDER

Application No. 65000.. Permit No. 47465.....  
IN NAME OF

WILLIAM H. & MARTHA A. GOODMAN

Surveyed Sept..3..... 1985., by B.W. BISHOP.....