


T.17 S., R.1 W., W.M.

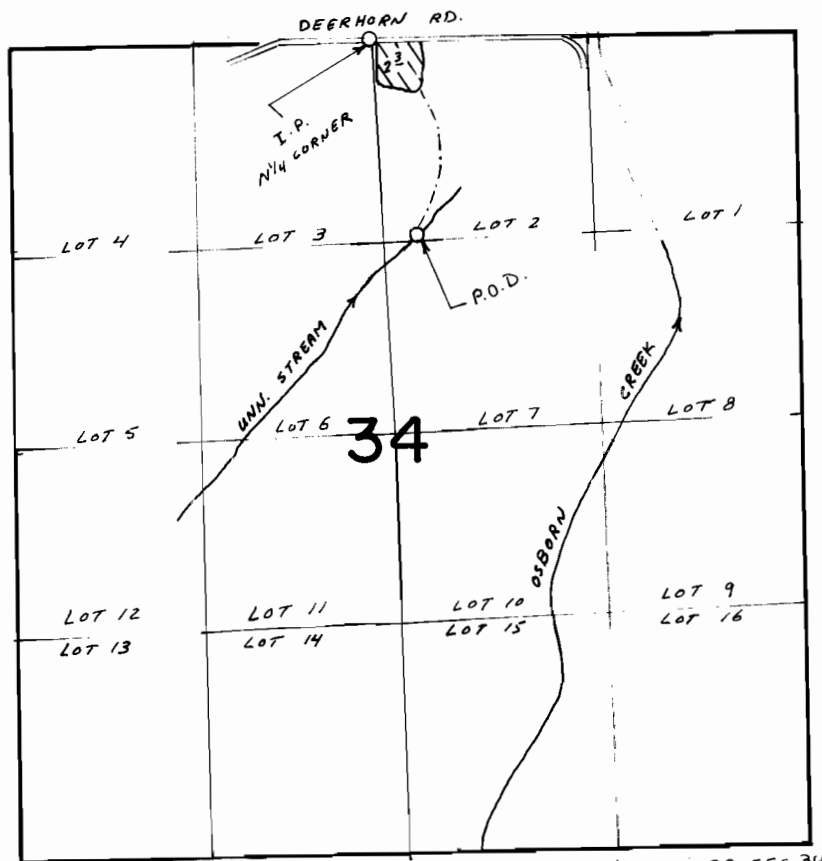

P.O.D. : 1400' SOUTH AND 240' EAST FROM N 1/4 CORNER SEC. 34

SCALE 1" = 1320'

FINAL PROOF SURVEY UNDER

Application No. 65472 Permit No. 47959
IN NAME OF

KARL BYERS, JR.

Surveyed APRIL 19 1988, by Z. SALEH

DBQ - 4JJ - 87
5-11-89 Z.f.S.