


T.17S., R.11W., W.M.

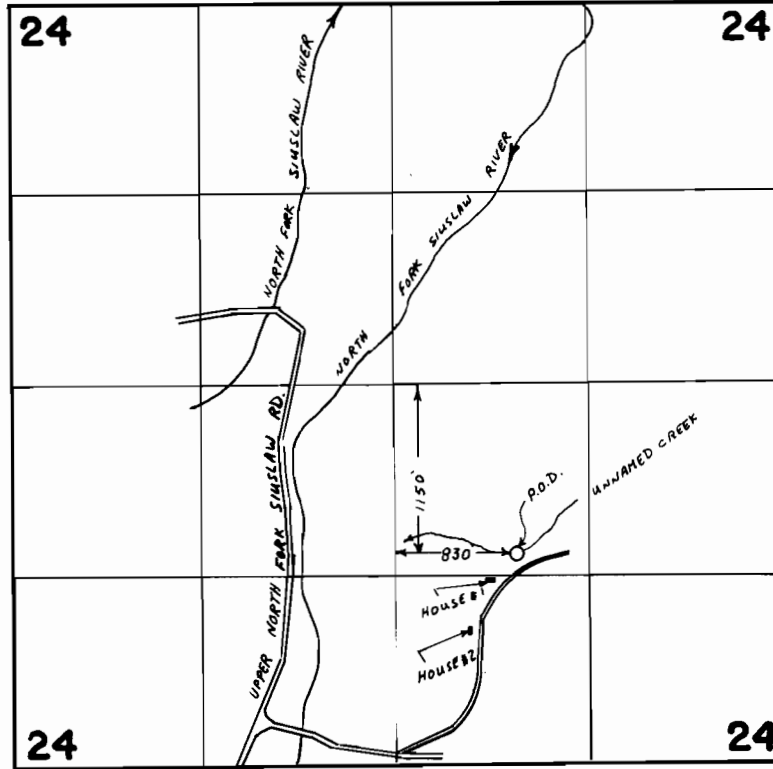

SCALE 1" = 1320'

FINAL PROOF SURVEY UNDER

Application No. **65811** Permit No. **48117**

IN NAME OF

CHESTER BERNHARDT

Surveyed **AUG. 10, 1988**, by **ZEIDAN SALEH**