


T.19S. R.12W. W.M.

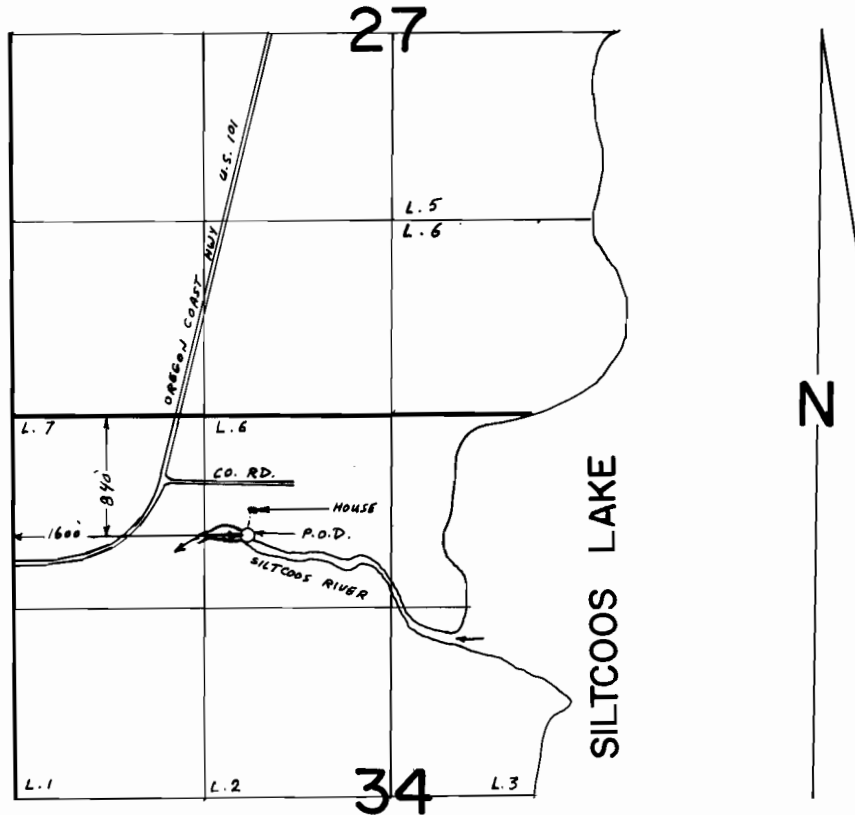

SCALE 1" = 1320'

FINAL PROOF SURVEY
UNDER

Application No. **68860** Permit No. **49776**

IN NAME OF
MALCOLM E. & EILEEN M. WRIGHT

Surveyed **AUG. 8 1988**, by **Z. SALEH**

DBQ-17H-98
5-10-89 Z.f.S.