


# T. 19 S., R. 12 W., W.M.

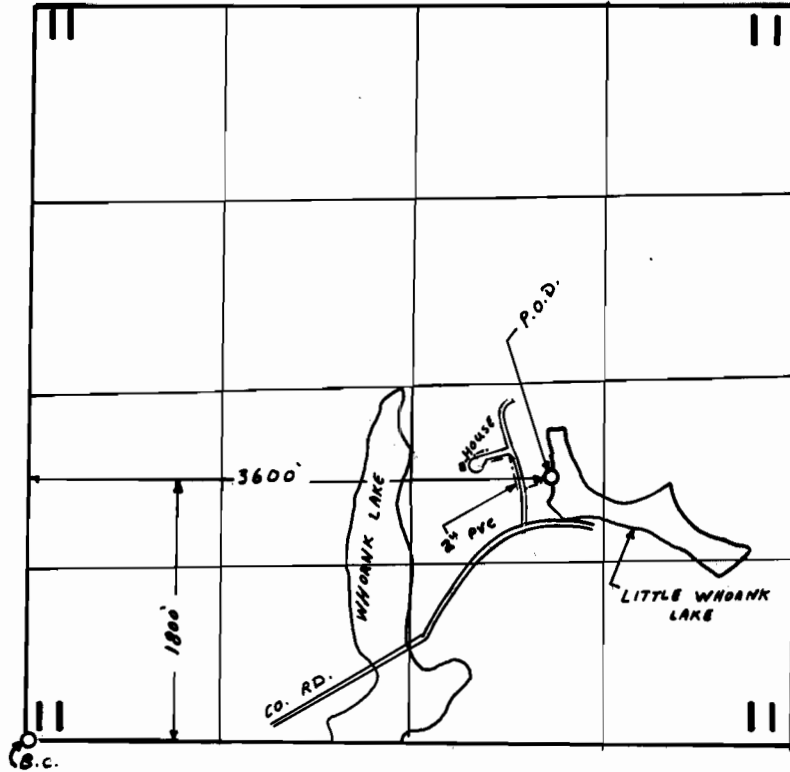

SCALE 1" = 1320'

## FINAL PROOF SURVEY UNDER

Application No. 68938 Permit No. 49948  
IN NAME OF

M. C. MOSHER & G. L. MOSHER

Surveyed AUG. 9 1988, by ZEIDAN SALEH

41039-128-172L  
4-25-89 z.f.s.