


T. 19 S., R. 12 W., W.M.

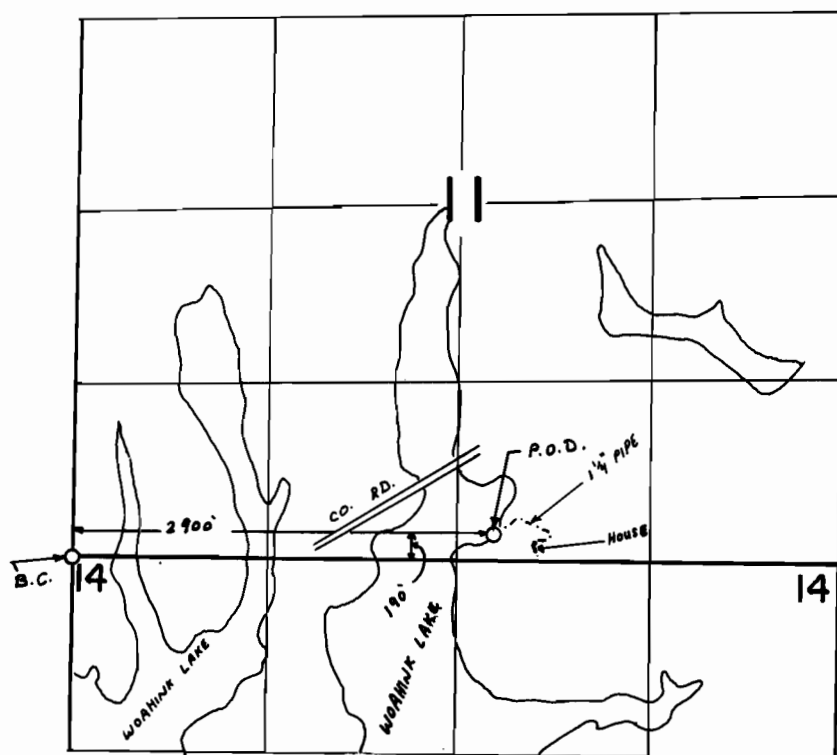

SCALE 1" = 1320'

FINAL PROOF SURVEY UNDER

Application No. **69184** Permit No. **50159**
IN NAME OF

MICHAEL COCCIOLO

Surveyed **AUG. 9, 1988**, by **ZEIDAN SALEH**