


T.13&14S.R.2E.W.M.

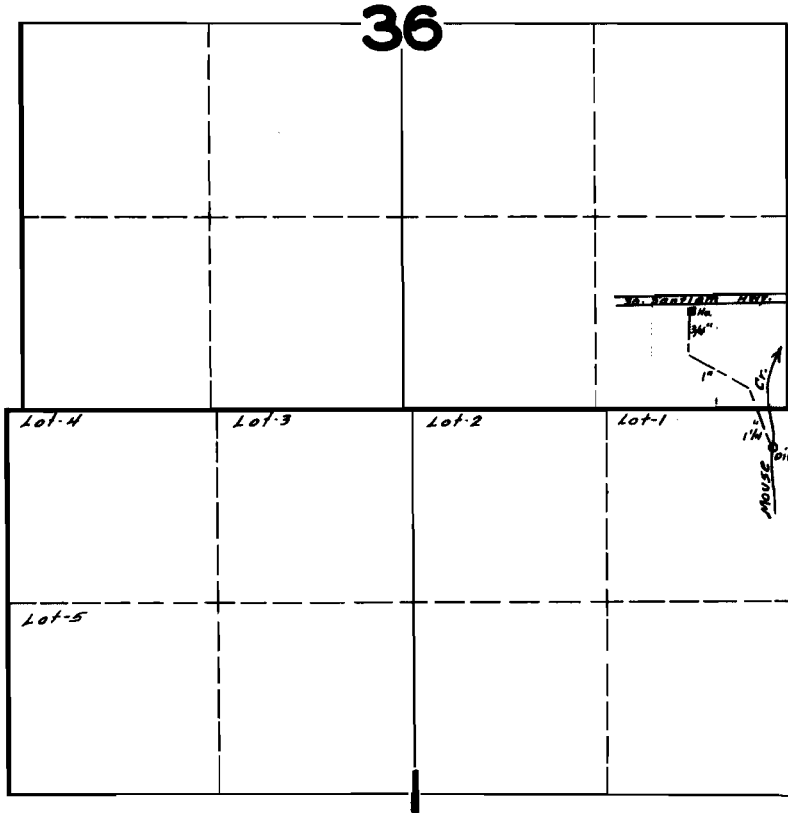

**FINAL PROOF SURVEY**  
UNDER

Application No. 20504 Permit No. 16006

IN NAME OF  
EVERETT LEE

Surveyed JUNE 26 1945 by [Signature]