


T.1N.&1S. R.13E. W.M.

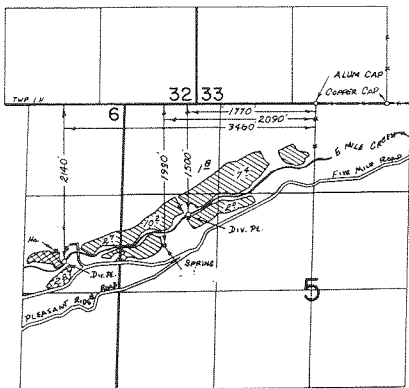

 CREEK
 SPRING & CREEK

FINAL PROOF SURVEY
UNDER

Application No. 57478... Permit No. 43396...
IN NAME OF

Estate of JESSE P. MILLER

Surveyed Oct. 16, 1984, by T. Paul.....