



G-8453  
62213

Application No. G-8971  
Permit No. G 8453

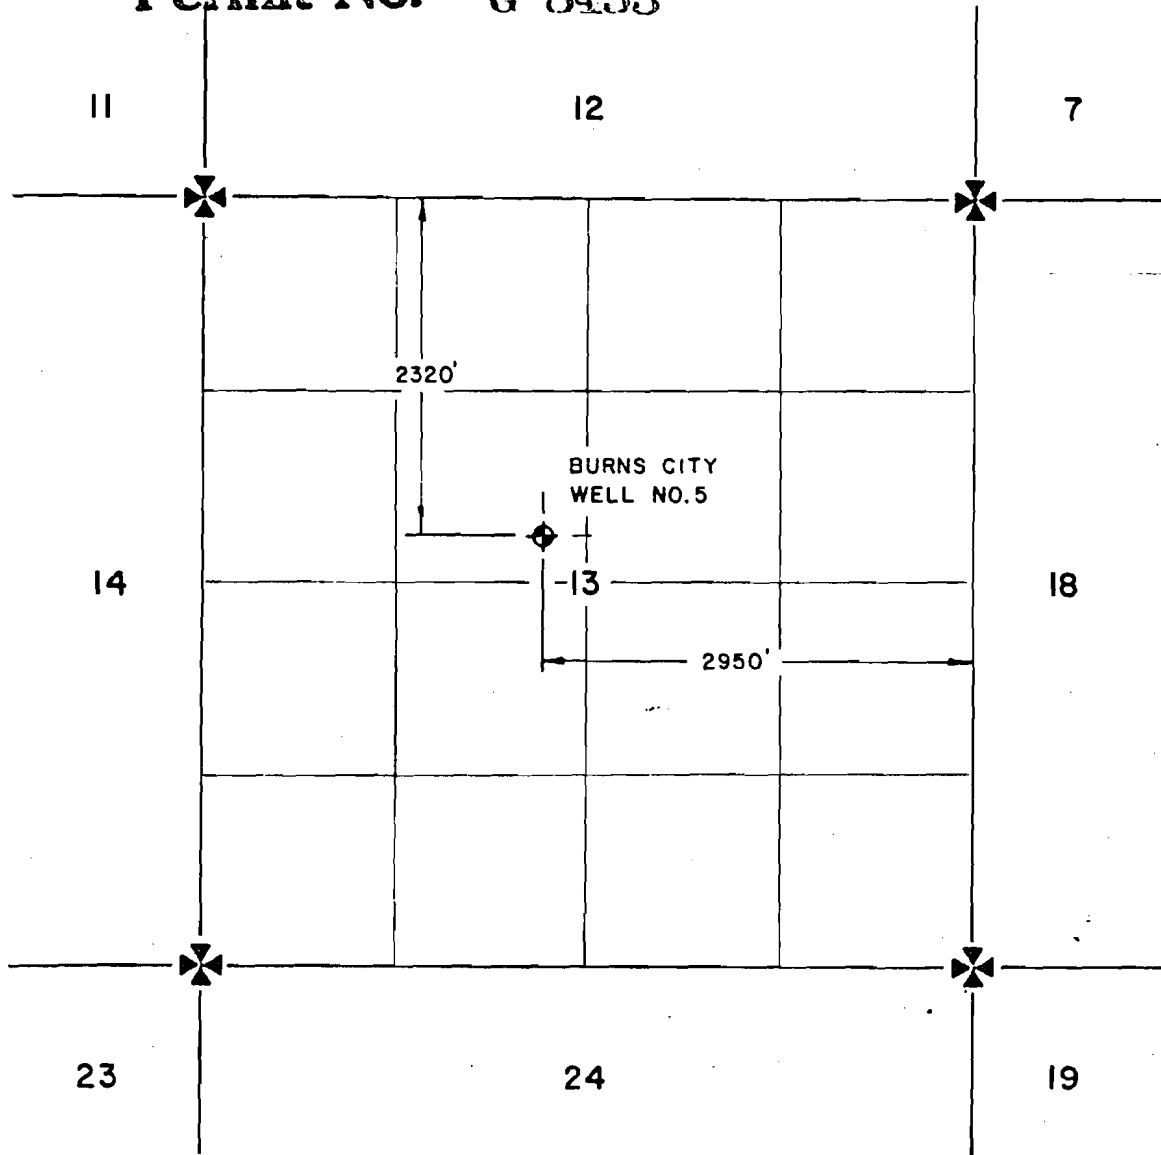

T23S, R30E, W.M.,  
HARNEY CO., OREGON

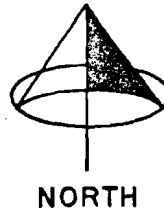

**RECEIVED**  
OCT 16 1978  
WATER RESOURCES DEPT.  
SALEM, OREGON

Design By	Drawn By J.C.	Checked By G.H.	Approv. By	Survey By	Date 9-28-78	Scale 4" = 1 mi	Drawing No. 0249.003.A9
-----------	------------------	--------------------	------------	-----------	-----------------	--------------------	----------------------------

CENTURY WEST ENGINEERING CORPORATION

BEND,  
OREGON