


T.27S., R.18E., W.M.

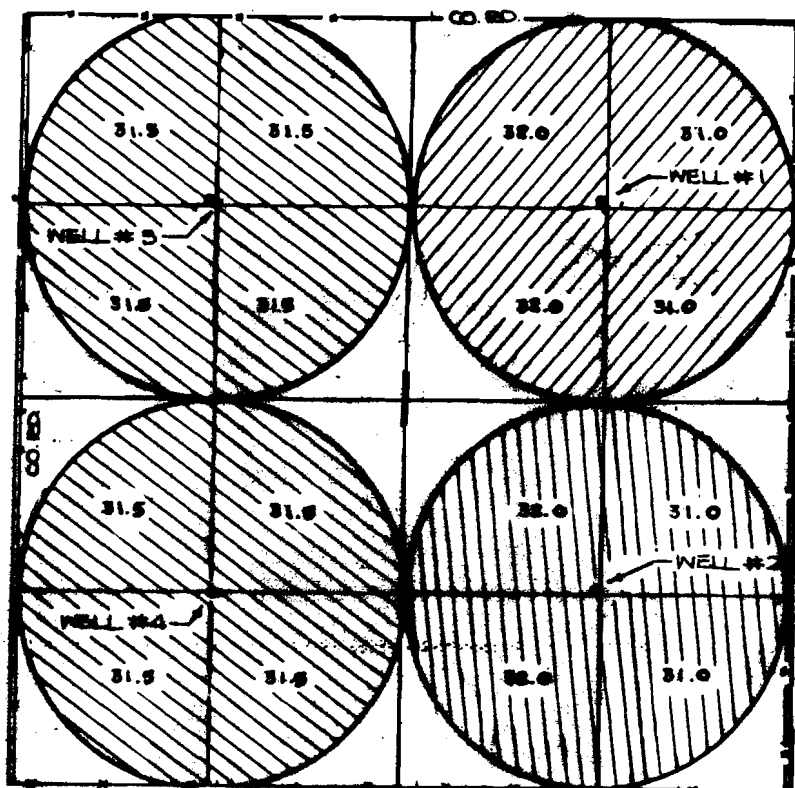

WELL #1 LOC.: 4000 FT. N. AND 3970 FT. E.;
WELL #2 LOC.: 1350 FT. N. AND 4000 FT. E.;
WELL #3 LOC.: 3970 FT. N. AND 1260 FT. E.;
WELL #4 LOC.: 1350 FT. N. AND 1350 FT. E.;
ALL FROM THE S.W. CORNER OF SECTION 1.

FINAL PROOF SURVEY
UNDER

SCALE: 4" = 1 MILE

G-10137 G-9175
G-9889 G-9072
Application No. G-9779. Permit No. G-9023.....
IN NAME OF

.....FLOWERREE FARMS, INC.

Surveyed JAN. 24, 1985, by J.L. OLSON