


G-9024
62216

T.26S.,R.18E.,W.M.

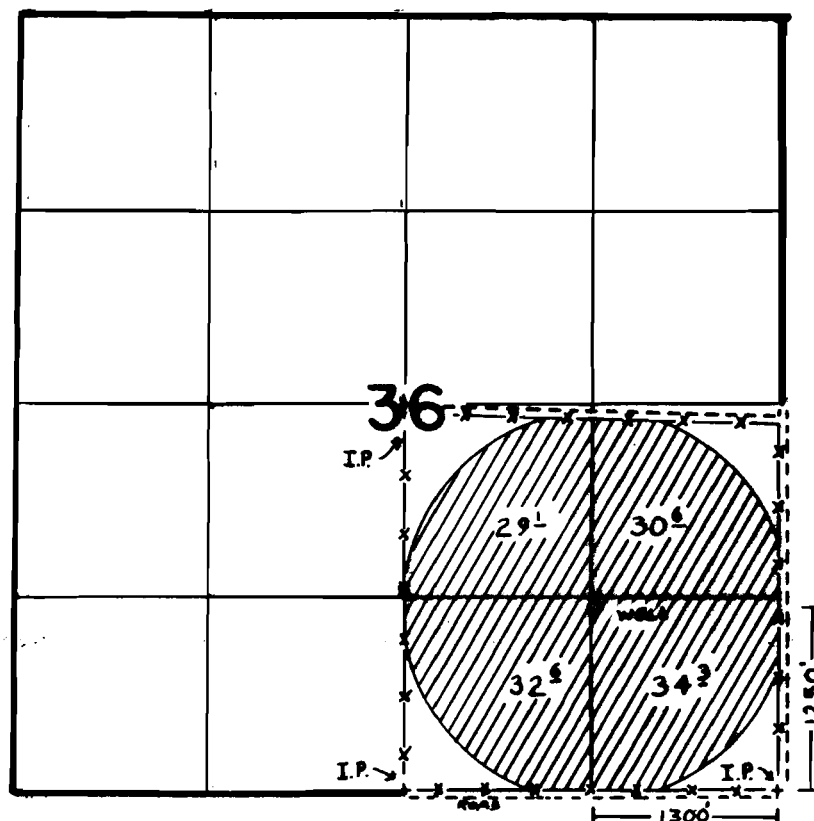

SCALE: 1"=1320'

FINAL PROOF SURVEY
UNDER

Application No. G-9780. Permit No. G-9024.....
IN NAME OF

FLOWERREE FARMS INC......

Surveyed APRIL 16, 1985, by LESLIE OLSON.....