


G-9072
6227

T.27S., R.18E., W.M.

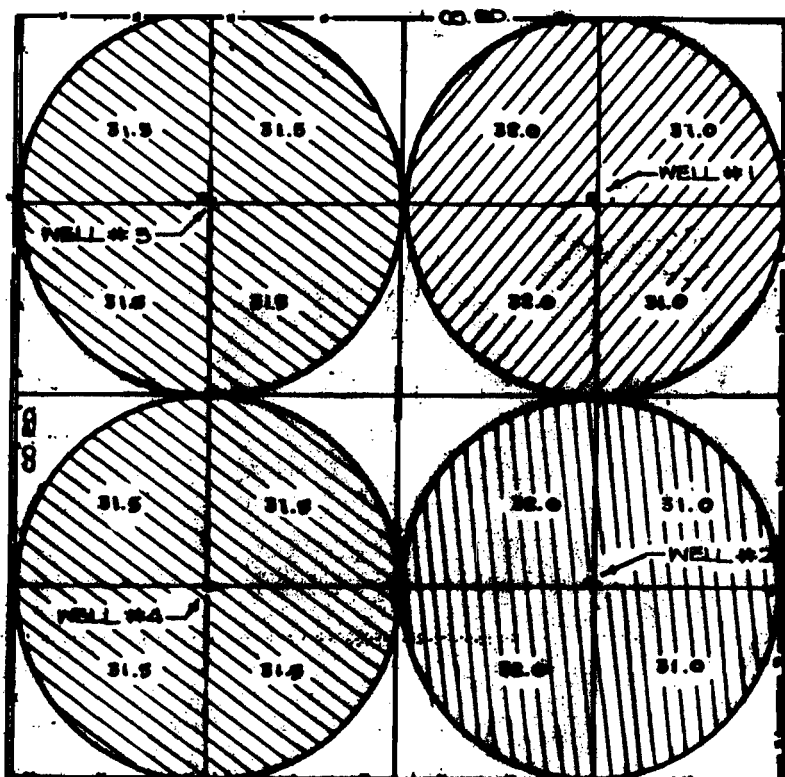

 G-9779
 G-9889
 G-10137

WELL #1 LOC.: 4000 FT. N. AND 3970 FT. E.)
WELL #2 LOC.: 1350 FT. N. AND 4000 FT. E.)
WELL #3 LOC.: 3970 FT. N. AND 1360 FT. E.)
WELL #4 LOC.: 1350 FT. N. AND 1360 FT. E.)
ALL FROM THE S.W. CORNER OF SECTION 1.



FINAL PROOF SURVEY UNDER

SCALE: 4" = 1 MILE

G-10137 G-9175
G-9889 G-9072
Application No. G-9779. Permit No. G-9023
IN NAME OF

.....FLOWERREE FARMS, INC.

Surveyed JAN. 24, 1985, by L. OLSON