



# T.27S., R.18E., W.M.

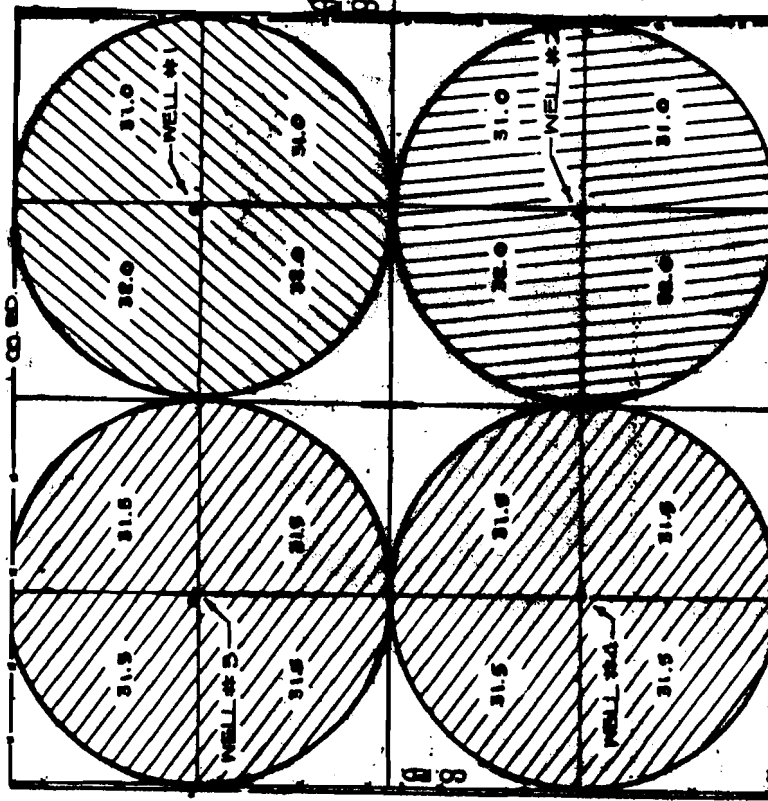

G-9779  
G-9889  
G-10137

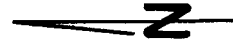

WELL #1 LOC.: 4000 FT. N. AND 1370 FT. E.  
WELL #2 LOC.: 1350 FT. N. AND 4000 FT. E.  
WELL #3 LOC.: 970 FT. N. AND 1260 FT. E.  
WELL #4 LOC.: 1350 FT. N. AND 1350 FT. E.  
ALL FROM THE S.W. CORNER OF SECTION 1.

FINAL PROOF SURVEY  
UNDER

SCALE: 4" = 1 MILE

G-9175  
62218