


T. 23 S., R.32 1/2 & 33 E., WM.

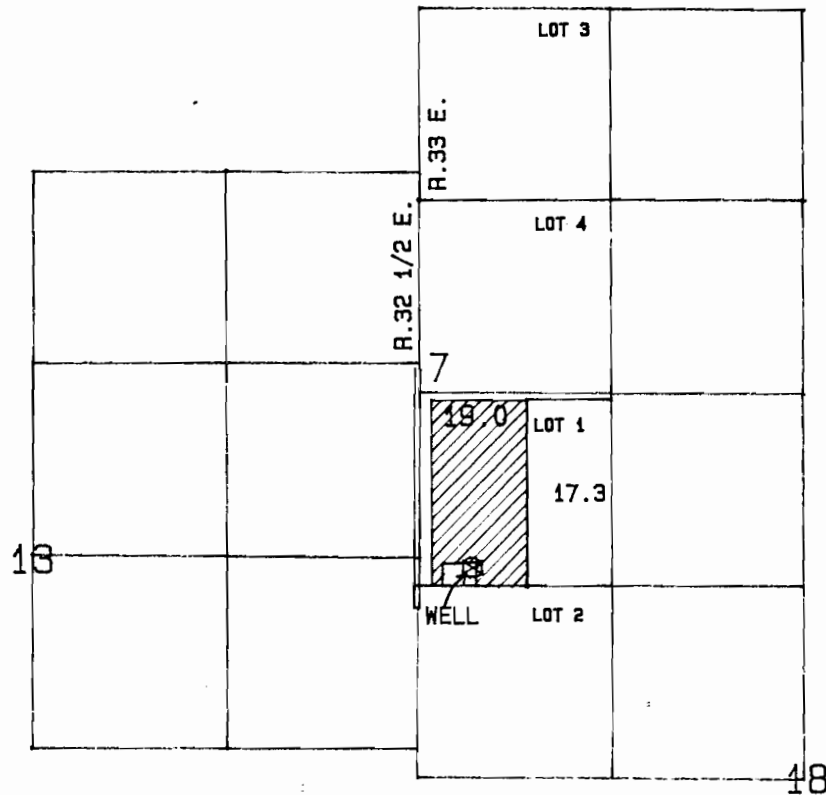

WELL LOCATED: 1180 FT SOUTH AND 360 FT EAST FROM THE  
NORTHWEST CORNER OF SECTION 18.

SCALE 1 IN = 1320 FT

FINAL PROOF SURVEY  
UNDER

APPLICATION NO.: G-10350

PERMIT NO.: G-9430

ROY STALDER & DONNA STALDER

SURVEYED MAY 20, 1986

BY: LARRY TOLL

COMPUTER DRAFTED: TMW  
PTS 1986 V-A