


T.25S., R.18E., W.M.

N

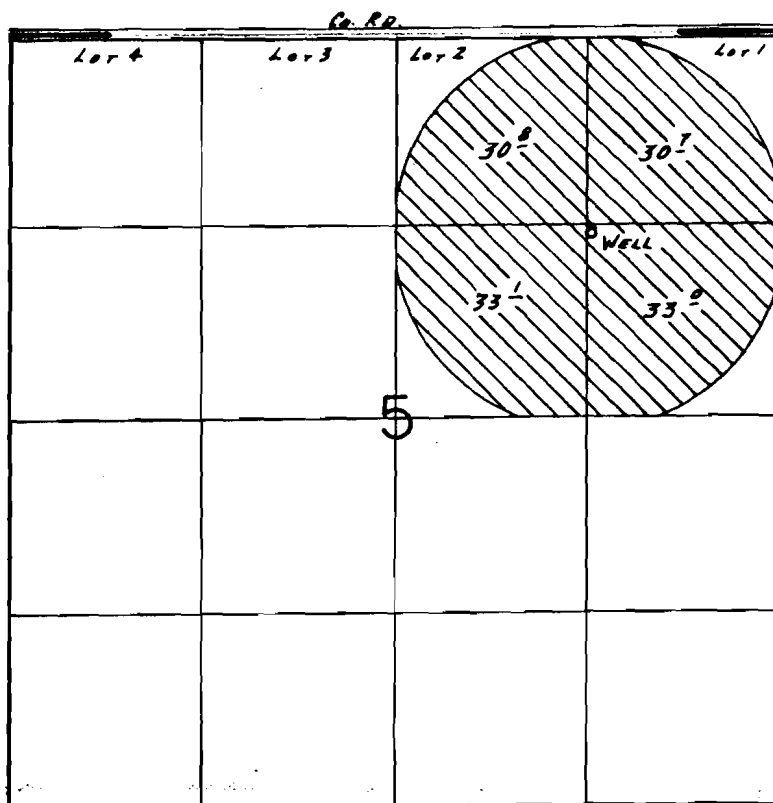

WELL LOC.: 1360'S. & 1300'W. FROM NE COR. SEC. 5.

SCALE: 1" = 1320'

FINAL PROOF SURVEY UNDER

Application No. G-10874 Permit No. G-10055...
IN NAME OF

.....TAYLOR RAMSEY.....

Surveyed JUNE 8.... 19.88, by B.W. BISHOP.....