


210418
62222

CANCELLED
SPON 44 P 324

T. 4N., R. 28E., W. M.

T 6318

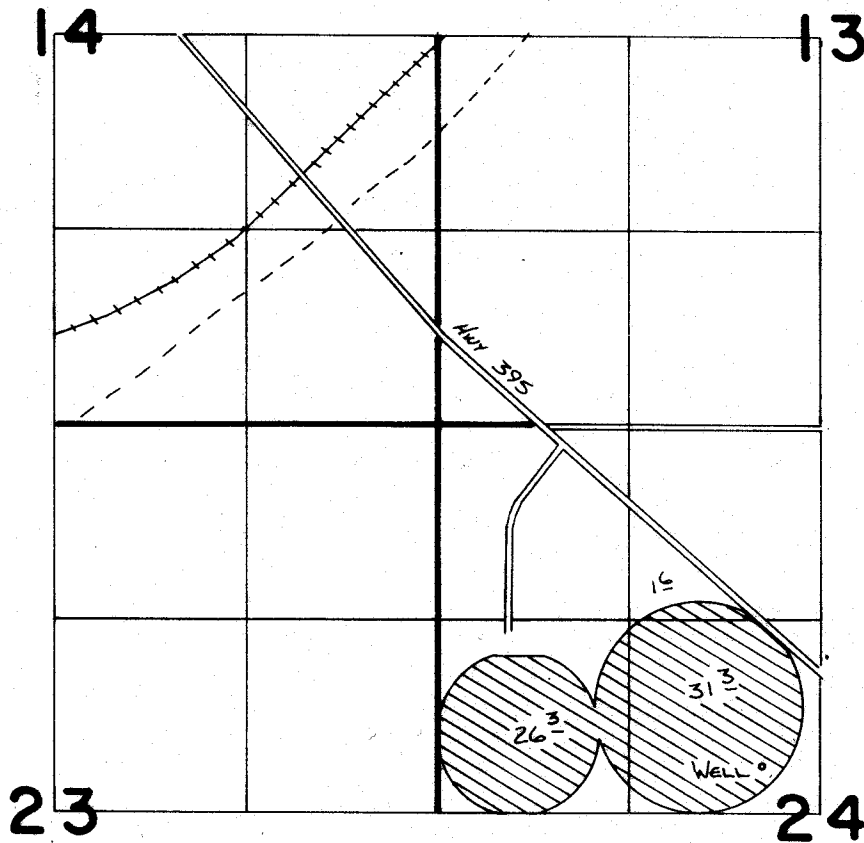

WELL LOC: 320' N. & 2240' E FROM W 1/4 CORNER SEC. 24

SCALE 1" = 1320'

FINAL PROOF SURVEY
UNDER

Application No. **G:11299** Permit No. **G:10418**
IN NAME OF

.....**ROBERT G. CAMPBELL**.....

Surveyed ..2..3..... 19.8.7, by ..V. L. Church.....