


T 4 S, R 2 E, WM

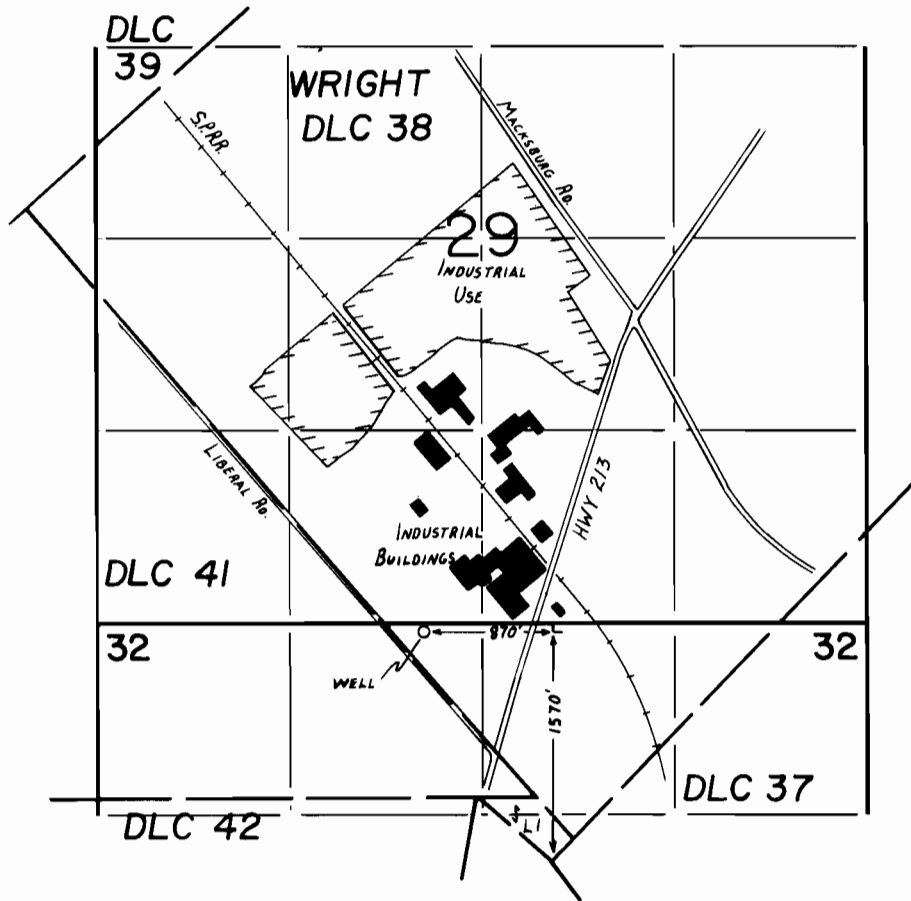

FINAL PROOF SURVEY UNDER

Transfer No. 4988...
 Application No. G-10810. Permit No. G-10649.
 IN NAME OF

.....
 Surveyed JULY 20, 1987., by T. M. WARREN.