
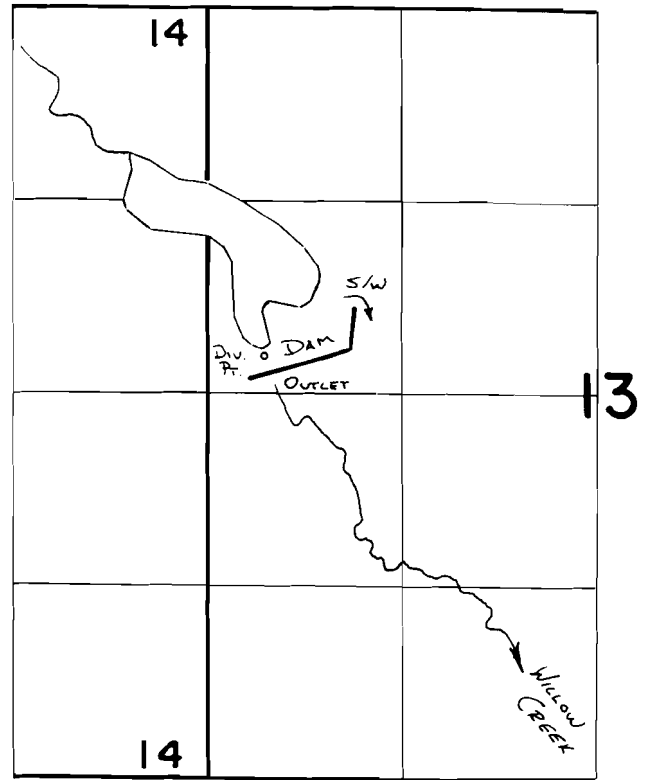


T. 24S., R. 29E., W.M.

T. 23S., R. 29E., W.M.

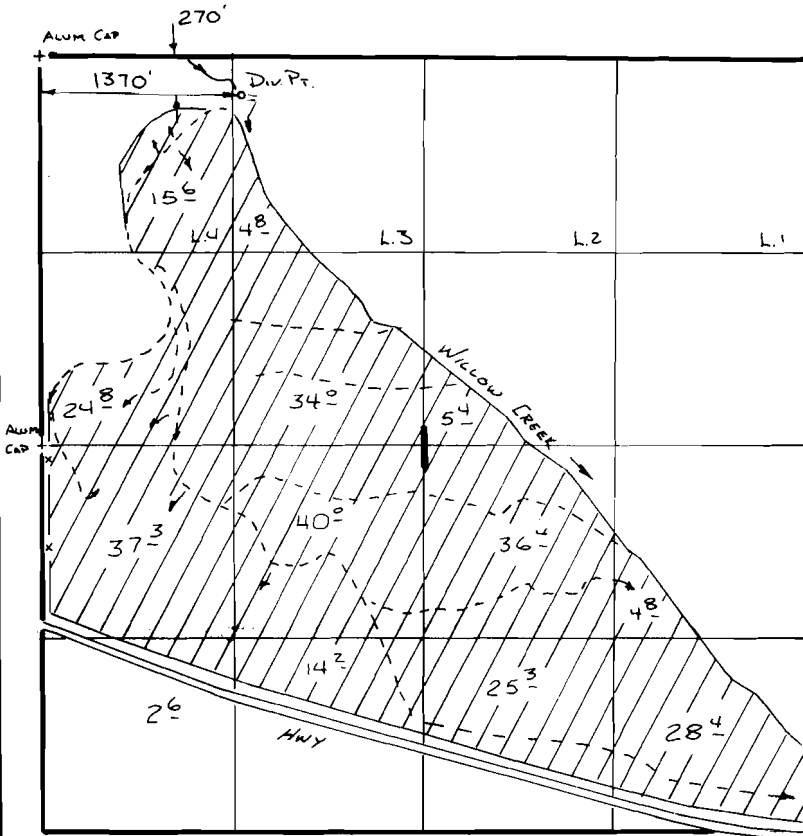

Div. Pt. Loc: 2380'S. & 390'E.
FROM NW COR. SEC. 13.

FINAL PROOF SURVEY

UNDER

R-43085

R-5084

SCALE 1" = 1320'

Application No. 43921.. Permit No. 32934.....

IN NAME OF

CHARLES & J.M. ERENO.....

Surveyed ..5-8..... 19.88, by B. SWE. JAMES.....