


T. 23S., R. 29E., W.M.

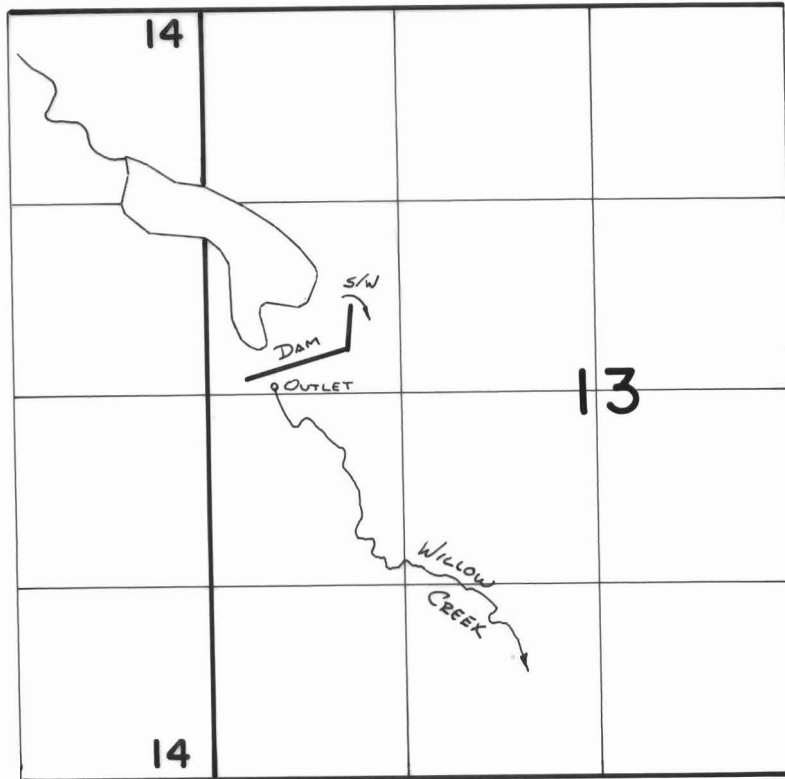

SCALE 1" = 1320'

Div. Pt. Loc: 2380'S & 390'E.
FROM NW COR. SEC. 13

FINAL PROOF SURVEY
UNDER

R-45543 R-5371
Application No. 45502. Permit No. 33949...
IN NAME OF

OREGON STATE GAME COMMISSION

Surveyed 5-8..... 19.88, by B.S. James.....