



T. 8S., R. 6W., W.M.

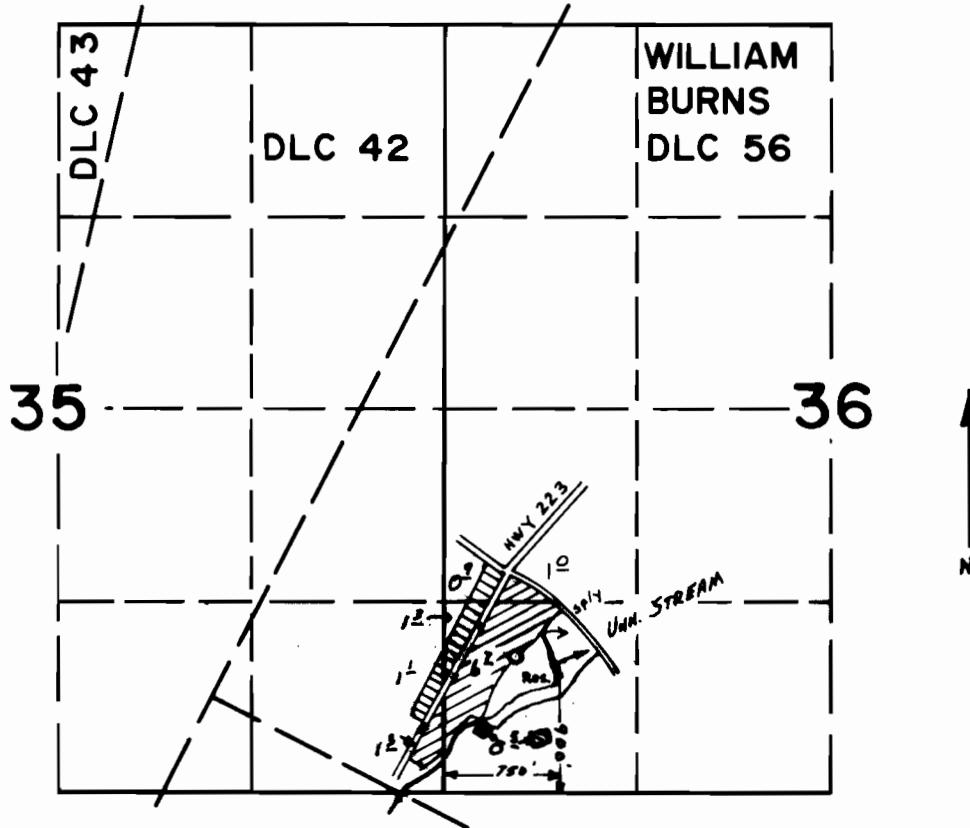

SCALE: 1" = 1320'

FINAL PROOF SURVEY UNDER

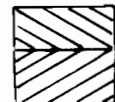

Permit
48111
Permit
41960

66903 48111
56241 41960

Application No. R-56240 Permit No. R-6633
IN NAME OF

JARROLD H. MCKIBBEN

Surveyed AUG 9 1982, by L. TOLL
MAY 6 1987 BW BISHOP

PTS-1983-Y
DFP-4LL-43
GEC

Revised 5-15-89 DM