


T 6 S, R 4 W, WM

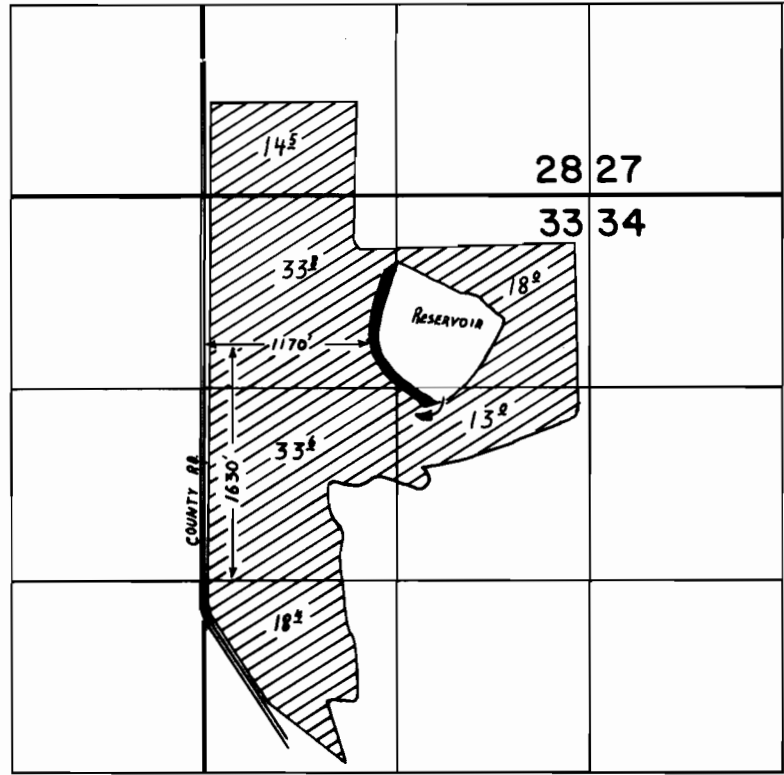

FINAL PROOF SURVEY UNDER

Application No. R-56688 Permit No. R-6643...
 56688 41971
 IN NAME OF

.....MARX FARMS INC.....

Surveyed APRIL 8, 1988, by T.M. WARREN...