


T 6 S, R 4 W, WM

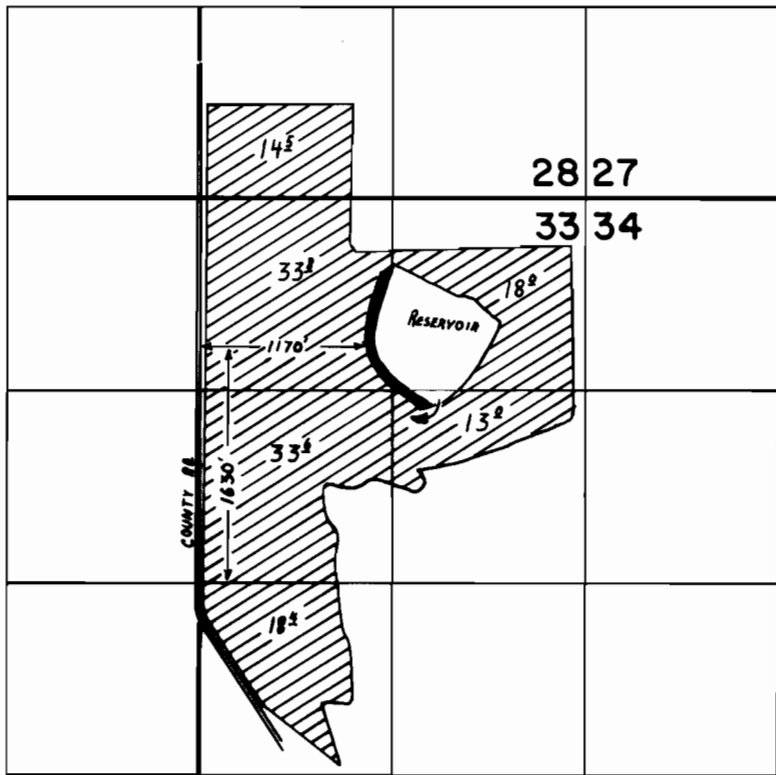

FINAL PROOF SURVEY UNDER

56688 41971
 Application No. R-56689 Permit No. R-6643....
 IN NAME OF

.....MARX FARMS INC.....

Surveyed APRIL 8, 1988, by T.M. WARREN...



SCALE
 1" = 1320'