


T.6S., R.6W., W.M.

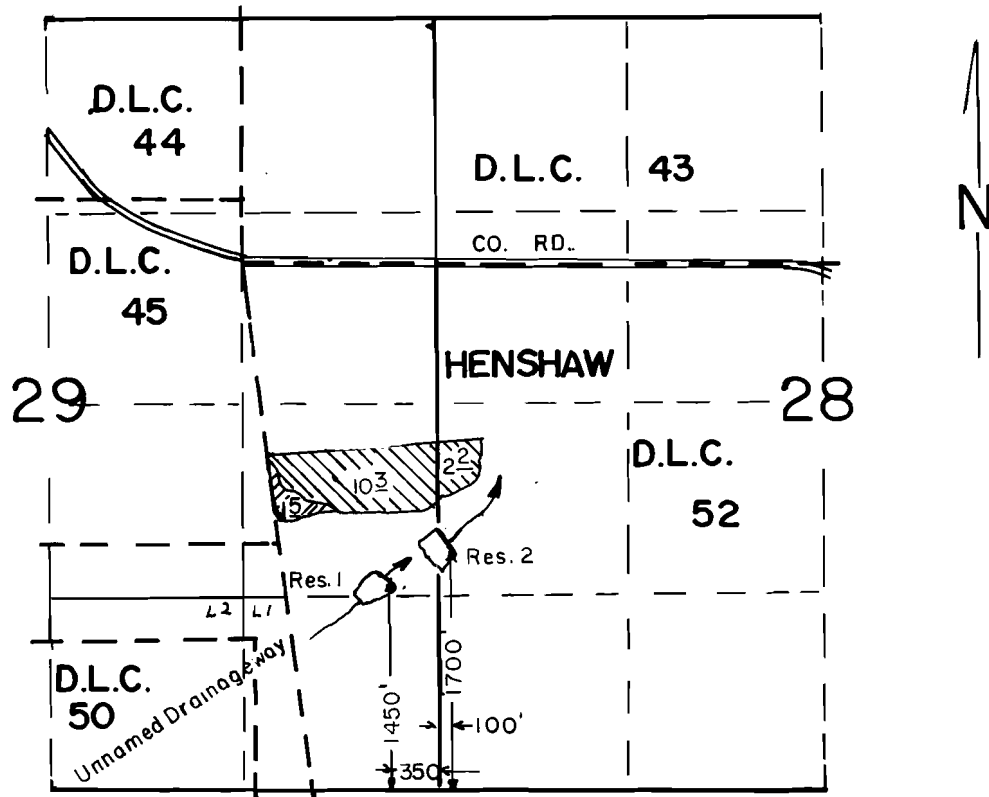

SCALE: 1"=1320'

FINAL PROOF SURVEY

UNDER


| | |
|---------|--------|
| R-56532 | R-6651 |
| 56533 | 41991 |
| R-61846 | R-8303 |
| 61847 | 45990 |

Application No. 61.487... Permit No. 4.5.6.71.....

IN NAME OF

LEONARD SEXTON

Surveyed APRIL 23, 1987, by B.W. BISHOP.....

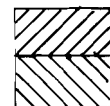

Permit 41991
Permit 45671