


T.6S., R.6W., W.M.

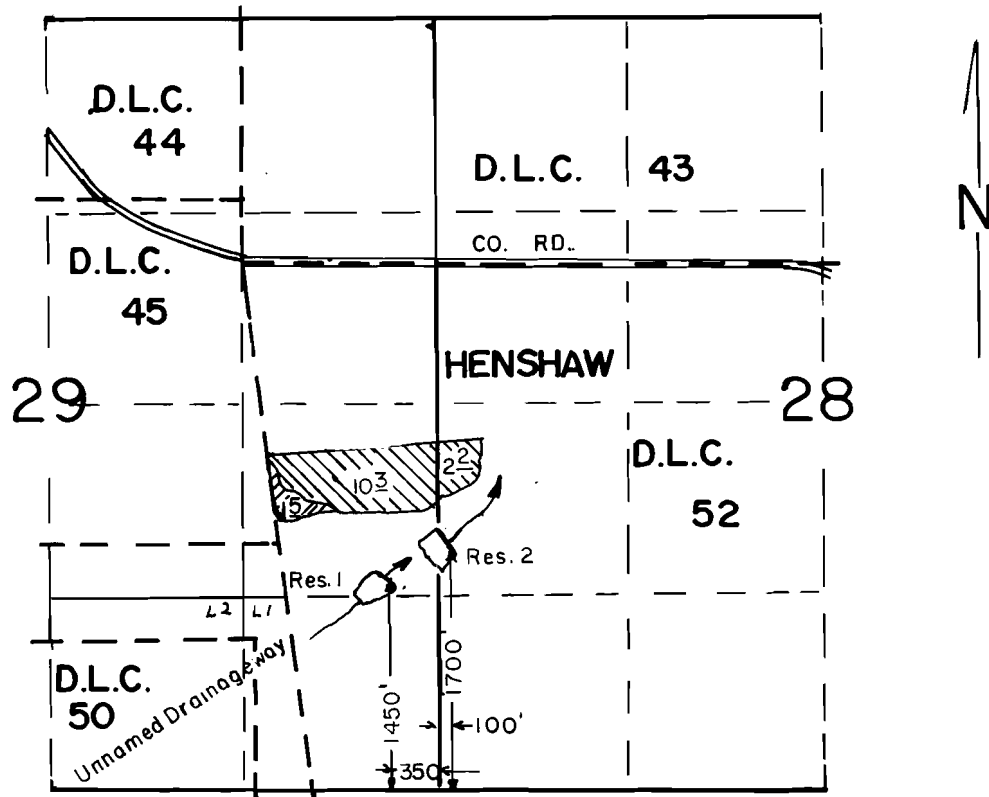

SCALE: 1"=1320'

FINAL PROOF SURVEY

UNDER


R-56532	R-6651
56533	41991
R-61846	R-8303
61847	45990

Application No. 61.487... Permit No. 4.5.6.7.1.....

IN NAME OF

LEONARD SEXTON

Surveyed APRIL 23, 1987, by B.W. BISHOP.....

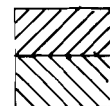

Permit 41991
Permit 45671